


KANSAS

Decatur

SECTION 9 TOWNSHIP 3 RANGE 29 W

WELL NO. #1 Cochran

COMPANY Anderson-Prichard

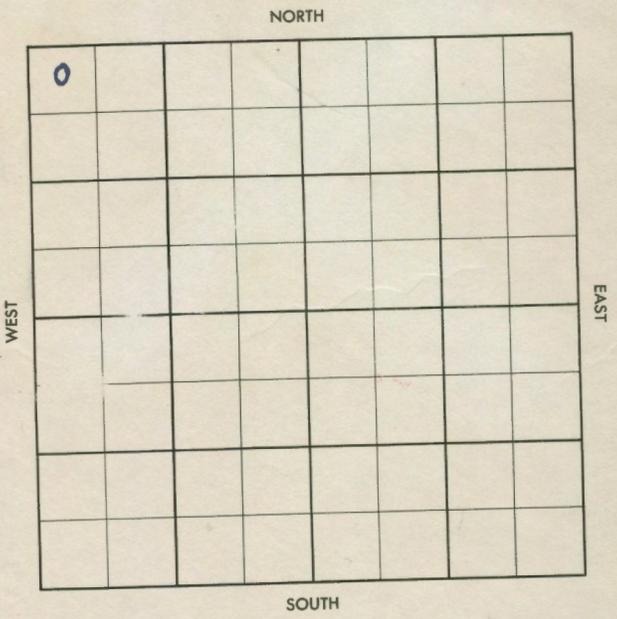

4

KANSAS

Decatur

SEC. 9 TWP. 3 R. 29W

WELL NO. #1 Cochran FARM

COMPANY Anderson Prichard


CONTRACTOR Glenn Peel
Pollnow

_____ Ft. from N. Line

_____ Ft. from S. Line

_____ Ft. from E. Line

_____ Ft. from W. Line

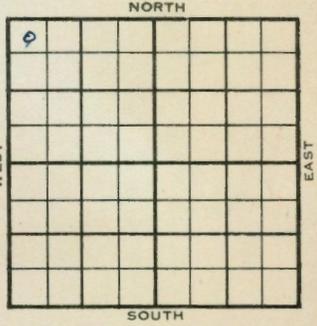

NE NW NW

	ELEVATION	REPORT
1955	2696'	
11/9	Comm 11-6-55 8" @ 194/175 WOC	
12-21	DST 3731-42, failed. DST 3730-42 op 1 hr. rec. 370' gas, 50' oil, 180' ho&gcm, 390/20" 5 1/2" @ 3793 CO to 3764, 32/ 3741-45 B/ 3/4 bo, 5% mw 3 hrs., 1000 A S/ 72 bo, 10 hrs., P/ 36 bo 6 hrs. P/ 29 bo 6 hrs. Comp. 149 BOPD H. 3668 Tr. 3699 L. 3709 TD 3930'	

COMPLETED

DX-78

County Decatur Elev. 2696
 Sec. 9 Twp. 3 Rge. 29W
 Company Anderson-Prichard
 FarmName Cochran No. 1

TOPS	DEPTH	LOG	DATUM	Loc. in Sec.
Anh.				NW NW NW
Tr.				
H.	<u>3668</u>		<u>972</u>	
Tr.	<u>3699</u>		<u>1003</u>	
Dg.				
Bl.				
L.	<u>3709</u>		<u>1013</u>	
K.C.				Geol.
B.K.C.				Contr.
Ce.				<u>Glenn Peel</u>
C.				Pool
M.				<u>Pollnow</u>
M.				
K.				
Mz.				
Me.				
V.				
S.				
S.				
A				
R.				
Pe.				
G.				
T.D.	<u>3930</u>			

Date Comm. 11-6-55 DEC 2 1 1955
8" @ 194/175 DST 3731-42 failed
DST 3730-42 open 1 hr. rec. 370' gas
50' oil 180' ho & gcm 390/20"
5 1/2" @ 3793 CO to 3764 32/ 3741-45
B/ 3/4 bo 5% mw 3 hr. 1000 A
S/ 72 bo 10 hr. P/ 36 bo 6 hr.
P/ 29 bo 6 hr. Comp. 149 bopd

County Decatur Elev. 2696
 Sec. 9 Twp. 3 Rge. 29W
 Company Anderson-Prichard
 FarmName Cochran No. 1

TOPS	DEPTH	LOG	DATUM	Loc. in Sec.
Anh.				NW NW NW
Tr.				
H.				
Tr.				
Dg.				
Bl.				
L.				
K.C.				Geol.
B.K.C.				Contr.
Ce.				<u>Glenn Peel</u>
C.				Pool
M.				<u>Pollnow</u>
M.				
K.				
Mz.				
Me.				
V.				
S.				
S.				
A				
R.				
Pe.				
G.				
T.D.				

Date Comm. 11-6-55
8" @ 194/175 WOC

FIRST REPORT
NOV 9 1955