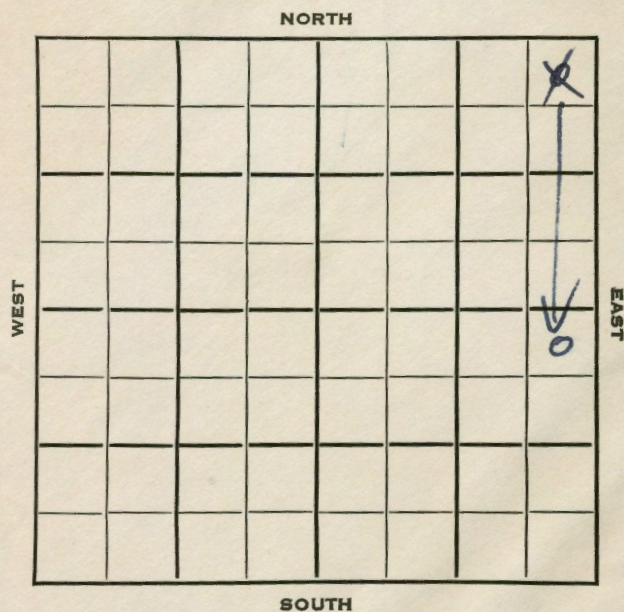


Section 23
26 Township 3 Range 29 WWell No. # 1 FeeCompany W. Sauvage

9

Decatur KANSAS
SEC. 23
26 TWP. 3 R. 29 W

1 Fee FARM

COMPANY

W. Sauvage

CONTRACTOR


Sauvage
Wildcat

330 Ft. from N. Line

Ft. from S. Line

330 Ft. from E. Line

Ft. from W. Line

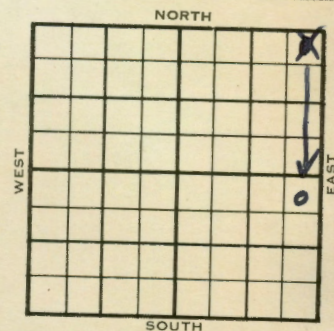NE NE NE
NE NE SE

1953 ELEVATION 2675' REPORT

9/30 Spud 9-26-53
8" @ 165
Drlg. 2200'

10/7 Spud 9-26-53 D & A TD 4337'
8" @ 165 Anhy 2503' Heeb 3769'
Lans 3805' B KC 4010' Cong 4233'
Gr wash 4269'
TD 4337' D & A

ABANDONED

County	Decatur		State	Kansas	
Sec.	26	(Blk. Twp.)	3	(Sur. Rge.)	29W Map No.
Operator	W. Sauvage				
Well No.	1	Farm	Fee		
Elev.	2675	Location	NE NE NE		
			330 Ft. From	N Line	NE
			330 Ft. From	E Line	Quarter
			1st. Report		
			Completion	OCT 7 1953	
			Remarks	Wildcat	
			Sauvage - Contr.		
			Spudding Date	9-26-53	
			Drig. Data	D & A	
			TD 4337		
			8" @ 165 Anhy 2503 Heeb. 3769		
Lans.	3805	B KC 4010	Cong.	4233	
Gr. wash	4269	TD 4337			
D & A					

J. G. McGEHEE

County Decatur State Kansas
Sec. 26 (Blk. Twp.) 3 (Sur. Rge.) 29W Map No.
Operator W. Sauvage
Well No. 1 Farm Fee
Elev. Location NE NE NE

 FIRST REPORT
330 Ft. From N Line NE
330 Ft. From E Line Quarter
1st. Report SEP 30 1953
Completion
Remarks Sauvage - Contr.
Spudding Date 9-26-53
Drig. Data Wildcat
8" @ 165 drlg. 2200

J. G. McGEHEE

Kansas

Map No. _____ Sec. 23 Twp. 3 R. 29W

Well No. 1 Fee

W. Sauvage Company

CORRECTION

NE NE SE

El. 2659 Contractor

SECTION PLAT

330 Ft. from N. Line

Ft. from S. Line

330 Ft. from E. Line

Ft. from W. Line

			o

Decatur County

Location

Rig up

Drilling and Remarks:

Comp. 10-7-53

NE NE NE

26-3-29W

RECORD

Cased _____ in., _____ ft.

Sand _____

Gas _____

Oil _____

Total Depth _____

PRODUCTION

1st 24 hrs. Nat. _____

1st 24 hrs. after shot _____

Gas _____ Cu. Ft.

Dry Hole _____

Abandoned _____

Date

OCT 21 1953

19

J. G. McGEHEE

Scout