


Section 19 Township 3 Range 32W

Well No. #1 Lewis "A"

Company Natural Gas & Oil & Ashland Ref.

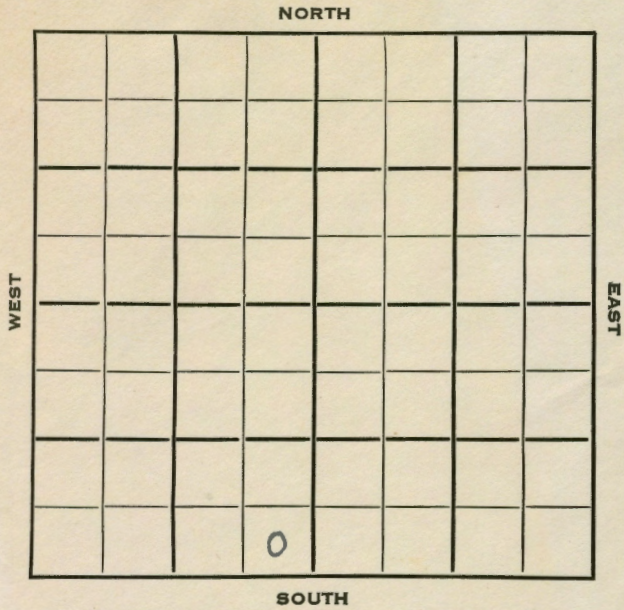

14


SEC. 19 TWP. 3 R. 32W

WELL NO. #1 Lewis "A" FARM

COMPANY Natural Gas & Oil & Ashland Ref.

CONTRACTOR Natural O & G. Wildcat.

_____ Ft. from N. Line
 330 _____ Ft. from S. Line
 330 _____ Ft. from E. Line
 _____ Ft. from W. Line

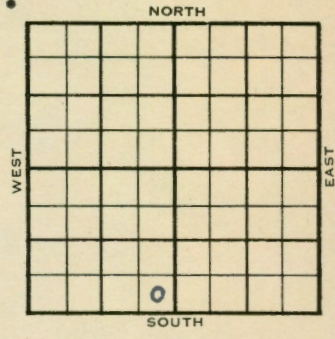

SE SE SW

1953	ELEVATION Elev. 3063'	REPORT
------	--------------------------	--------

11/11 R U R
 11/18 8" @ 240
 Drlg. 3340
 12/2 Spud 11-10-53
 D&A
 TD 4666'
 8" @ 240'
 Ft. Hays 1400', Odell 1365', Dakota 1750', Anhy 2823', Neva 3416', Admire 3544', Howard 3840', Top 3859'
 DST 3953-4000', opn 1 hr., rec. 155' mud, 260#
 Tor 4029', KC 4037
 DST 4032-54', opn 1 1/2 hrs., rec. 1510' sw, 1240#
 DST 4213-52', opn 1 hr., rec. 40' mud 160#
 B KC 4313', Marm. 4323', Cherokee 4418', Miss 4622', Gilmore City 4640'
 TD 4666'
 D&A

ABANDONED

