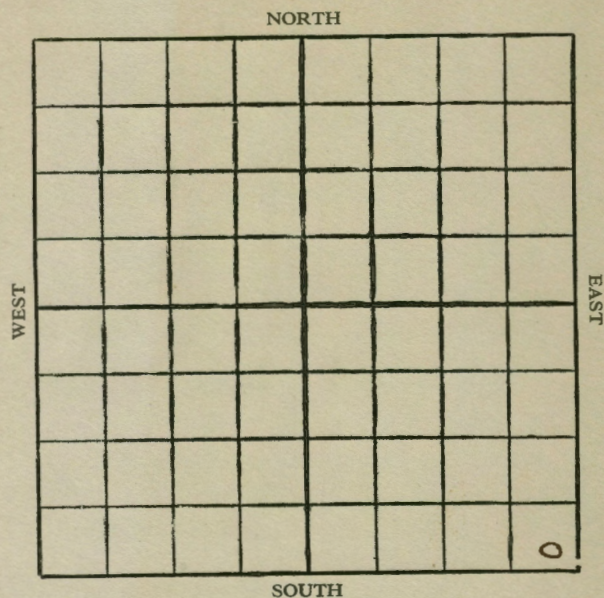


Map No. Sec. 5 Twp. 3 R. 34Well No. 1 FarmCompany Bison Oil

Location

Drilling Remarks

Rig Up

Drilling Remarks

RECORD

Cased in. ft.

Sand

Gas

Oil

Total Depth

PRODUCTION

1st 24 hrs. Nat.

1st 24 hrs. after shot

Gas cu. ft.

Dry Hole

Abandoned


16

Map No. Sec. 5 Twp. 3 R. 34Well No. 1 FarmCompany Bison Oil

Ft. from N. Line

300 Ft. from S. Line300 Ft. from E. Line

Ft. from W. Line

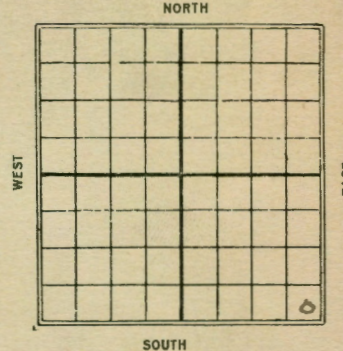

1927

Date

REPORT

2/2 Drlg 600'

2/9 " 1500

2/16 no report

2/23

3/2 T.D. 1610 S.D. for pipe

3/9 no report

3/16 Drlg 2020

3/23 " 2088

3/30 no report

4/6

4/13 T.D. 2385 - S.D. for orders

4/20

4/27

5/4

5/11

5/18

5/25

6/1 Drlg 2725

6/15 no report

6/22 Drlg 2860

6/29 no report

7/6

7/13 - Drly 2940
7/20 - no report
7/27 - T.D. 3076 - S. & G.

Form 24 1M Bks. 3-23-11959.

Map No. KANSAS Sec. 5 Twp. 3 R. 34W

Well No. 1

Bison Oil Company

Contractor

SECTION PLAT

-----Ft. from N. Line

300 Ft. from S. Line

300 Ft. from E. Line

-----Ft. from W. Line

			0

FIRST REPORTS

Location -----

Rig up -----

Drilling and Remarks:

Drly 600

RECORD

Cased ----- in., ----- ft.

Sand -----

Gas -----

Oil -----

Total Depth -----

PRODUCTION

1st 24 hrs. Nat. -----

1st 24 hrs. after shot -----

Gas ----- Cu. Ft.

Dry Hole -----

Abandoned -----

Date

FEB 2 1927

S. J. LEWIS Scout

MAP NO. _____ SEC. 5 TWP. 3S R. 34WWELL NO. 1 Brathem_____
Bison COMPANY_____
Mo well dmp CONTRACTOR

SECTION PLAT

			0

Ft. FROM N. LINE_____
Ft. FROM S. LINE_____
Ft. FROM E. LINE_____
Ft. FROM W. LINE

LOCATION _____

RIG UP _____

DRILLING AND REMARKS:

RECORD

CASED _____ IN. _____ FT.

SAND _____

GAS _____

OIL _____

TOTAL DEPTH 3076

PRODUCTION

1ST 24 HRS. NAT. _____

1ST 24 HRS. AFTER SHOT _____

GAS _____ Cu. Ft.

DRY HOLE ☒ABANDONED ☒

DATE

8/1 1927 _____ SCOUTMAP NO. _____ SEC. 5 TWP. 3 R. 34WWELL NO. 1 Gordon_____
Bison Oil Company_____
Contractor

SECTION PLAT

			0

Ft. from N. Line300 Ft. from S. Line300 Ft. from E. Line_____
Ft. from W. Line**ABANDONED**

Location _____

Rig up _____

Drilling and Remarks:

TD 3076DYA

RECORD

Cased _____ in., _____ ft.

Sand _____

Gas _____

Oil _____

Total Depth _____

PRODUCTION

1st 24 hrs. Nat. _____

1st 24 hrs. after shot _____

Gas _____ Cu. Ft.

Dry Hole ☒Abandoned ☒

Date

JUL 27 1927 _____
1927 _____
S. J. LEWIS Scout