


Section 8 Township 3 Range 38W

Well No. #1 Beeson

Company Service Drlg. Co.

NORTH

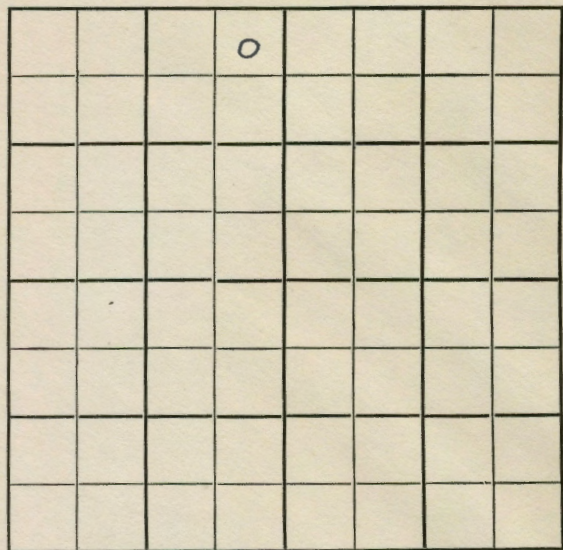

SOUTH

EAST

WEST

3

Sec. 8 Twp. 3 R. 38W

Well No. #1 Beeson Farm

Service Drlg. Co. Company

Service Wildcat - Arb. test 5100' Contractor


330 Ft. from N. Line

Ft. from S. Line

330 Ft. from E. Line

Ft. from W. Line

NORTH

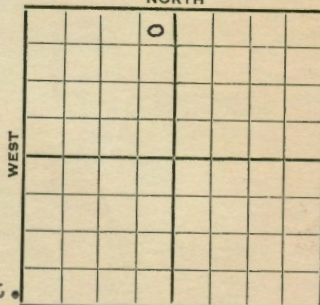

SOUTH

NE NE NW
Skelly DHM \$1.00 per ft.

1952 **Elev. 3508'** REPORT

- 2/27 Spud 2-19-52
8" @ 170'
1 st Dakota 2250 Anhy 2400
Drlg. 2725'
- 3/5 Ran Schl at 3018'
Drlg. 3645'
- 3/12 **Cherty Foreacher 3970'**
@ 4139-44' had limestone with heavy
black oil stain, poor porosity.
To Core.
- 3/19 **Shawnee 4239 Topeka 4244**
Burbank 4294 Lans. 4488
DST 4540-95 1 hr. 90 M 1' HO on Btm
Coring 4204-17 13' sh & limestone
DST 4598-4650 45 mins 45' wtry
mud Drlg. 4656'
- 4/2 Spud 2-19-52 D&A TD 5392
8" @ 170 1st Dakota 2250
Anhy 3360 Cherty Foracher 3970
Shawnee 4239 Top. 4244
Deer Creek 4294 Lans. 4488
DST 4540-95 opn 1 hr. Rec. 90' mud
DST 4598-4650 opn 45 min. Rec. 45'
waterymud **BKC 4727 Cherokee 4962**
Miss 5189 Arb. 5375 TD 5392
D&A

ABANDONED

County Cheyenne State Kansas
 Sec. 8 (Blk. 3 (Sur. 38W Map No.
 (Twp.) (Rge.)
 Operator Service Drlg. Co.
 Well No. 1 Farm Beeson
 Elev. 3508 Location NE NE NW

0			

ABANDONED

330 Ft. From N Line NW
 330 Ft. From E Line Quarter
 Ist. Report
 Completion APR 2 1952
 Remarks Wildcat
Service Drlg. - Contr.
 Spudding Date 2-19-52

Drlg. Data D & A TD 5392
8" @ 170 1st Dakota 2250 Anhy 3360
Cherty Foracher 3970 Shawnee 4239
Top. 4244 Deer Creek 4294 Lans. 4488
DST 4540-95 open 1 hr. Rec. 90' mud
DST 4598-4650 open 45 min. Rec. 45'
watery mud. B KC 4727 Cherokee 4962
Miss. 5189 Arb. 5375 TD 5392

D & A

J. G. McGEHEE

County Cheyenne State Kansas
 Sec. 8 (Blk. 3 (Sur. 38W Map No.
 (Twp.) (Rge.)
 Operator Service Drlg. Co.
 Well No. 1 Farm Beeson
 Elev. Location NE NE NW

0			

FIRST REPORT

330 Ft. From N Line NW
330 Ft. From E Line Quarter
 Ist. Report FEB 27 1952
 Completion
 Remarks Skelly -DHM \$1.00
Service -Contr. per. ft.
 Spudding Date 2-19-52

Drlg. Data Wildcat -Arb test 5100'
8" @ 170 1st Dakota 2250 Anhy 2400
Drlg 2725

J. G. McGEHEE