


Section 28 Township 4 Range 13W

Well No. 1 Jacobs

Company E. W. Whitney, Tonkawa, Okla.

NORTH

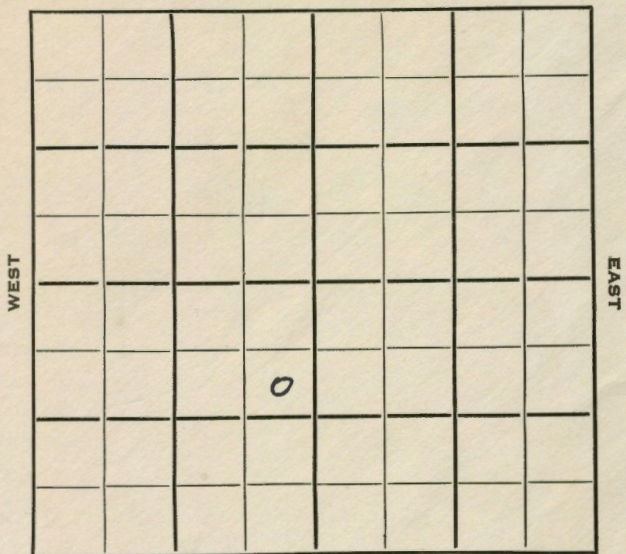

SOUTH

11

Smith KANSAS

SEC. 28 TWP. 4 R. 13W

WELL NO. #1 Jacobs FARM

COMPANY E.W. Whitney, Tonkawa, Okla.

CONTRACTOR


Wildcat.

990 Ft. from N. Line

Ft. from S. Line

330 Ft. from E. Line

Ft. from W. Line

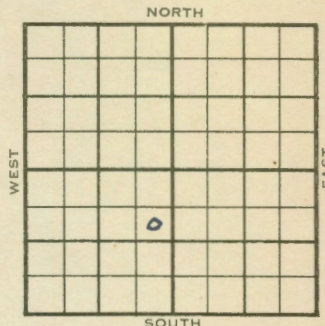

SE NE SW

	ELEVATION	REPORT
1953	1731 -1733'	IS
9/16	Spud 9-4-53 8" @ 202'	Miss 3678', Arb 4175' TD 4200' (Holding for Tops) D & A
9/23	D&A	
9/30	Spud 9-4-53 8" @ 202'	D & A TD 4198 Top 2797 Heeb 3117 Lans 3161 B KC 3415 Miss 3678 Simp 4119 Arb. 4173 TD 4198 D & A

ABANDONED

