


FORM 51 5M 4-41 PETROL

Section 6 Township 4 Range 17-W

Well No. #1 Loyd

Company Helmerich & Payne et al

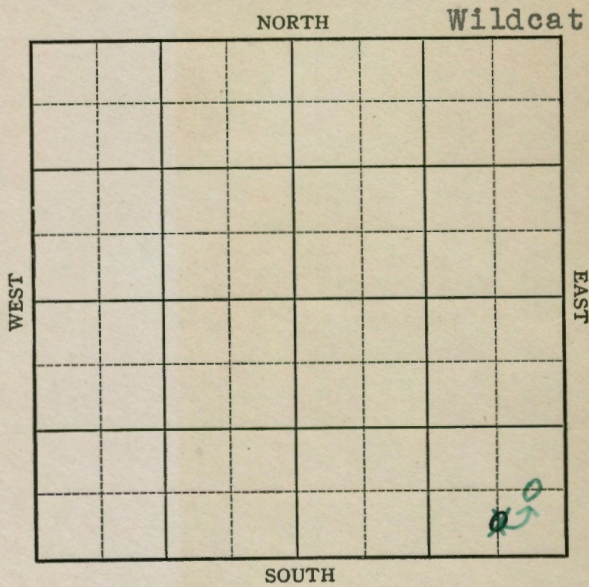

16

Sec. 6 Twp. 4 R. 17-W

Well No. #1 Loyd Farm

Helmerich & Payne et al Company  
(Wildcat)


\_\_\_\_\_ Ft. from N. Line

~~330~~ <sup>660</sup> Ft. from S. Line

~~660~~ <sup>330</sup> Ft. from E. Line

\_\_\_\_\_ Ft. from W. Line

Elev. 1854

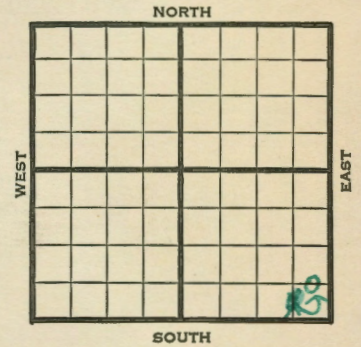

1941	REPORT
5/27	S. H.
6/5	12" - 200' Anhy 1640' Drlg. 2250'
6/12	Topeka 2886' Lans. 3158' Cong. 3552' Drlg. 3620'
	No shows.
6/18	Topeka 2886' Lans. 3158' Viola 3641' Arb. 3681' T.D. 3830' No shows.
	<b>ABANDONED</b>

Map No. 132 Sec. 6 Twp. 4 R. 17W

Well No. 1 Loyd

Helmerich & Payne etal Company

Contractor

**ABANDONED**

**SECTION PLAT**

C E L S E S E

\_\_\_\_\_ Ft. from N. Line

660 Ft. from S. Line

330 Ft. from E. Line

\_\_\_\_\_ Ft. from W. Line


WILDCAT

Location \_\_\_\_\_

**RECORD**

Cased \_\_\_\_\_ in., \_\_\_\_\_ ft.

Sand \_\_\_\_\_

Gas \_\_\_\_\_

Oil \_\_\_\_\_

Total Depth 3830

**PRODUCTION**

1st 24 hrs. Nat. \_\_\_\_\_

1st 24 hrs. after shot \_\_\_\_\_

Gas \_\_\_\_\_ Cu. Ft.

Dry Hole \_\_\_\_\_

Abandoned \_\_\_\_\_

Rig up \_\_\_\_\_

Drilling and Remarks:

*Yoga ka 2886*

*Leave 3158*

*Vista 3641*

*Co 43687*

*Nochwood*

Date

JUN 18 1941 19

S. J. LEWIS Scout

Map No. 132 Sec. 6 Twp. 4 R. 17W

Well No. 1 Loyd

Helmerich & Payne etal Company

Contractor

**FIRST REPORT**

**SECTION PLAT**

C S L S E S E

\_\_\_\_\_ Ft. from N. Line

330 Ft. from S. Line

660 Ft. from E. Line

\_\_\_\_\_ Ft. from W. Line


WILDCAT

Location \_\_\_\_\_

**RECORD**

Cased \_\_\_\_\_ in., \_\_\_\_\_ ft.

Sand \_\_\_\_\_

Gas \_\_\_\_\_

Oil \_\_\_\_\_

Total Depth \_\_\_\_\_

**PRODUCTION**

1st 24 hrs. Nat. \_\_\_\_\_

1st 24 hrs. after shot \_\_\_\_\_

Gas \_\_\_\_\_ Cu. Ft.

Dry Hole \_\_\_\_\_

Abandoned \_\_\_\_\_

Rig up \_\_\_\_\_

Drilling and Remarks:

*S.H.*

Date

MAY 27 1941 19

S. J. LEWIS Scout

Map No. 132 Sec. 6 Twp. 4 R. 17W

Well No. 1 Loyd

Helmerich & Payne etal Company

CORRECTION

Contractor

**SECTION PLAT**

**C E L S E S E**

\_\_\_\_\_ Ft. from N. Line

660 Ft. from S. Line

330 Ft. from E. Line

\_\_\_\_\_ Ft. from W. Line

			o

**WILDCAT**

Location \_\_\_\_\_

Rig up \_\_\_\_\_

Drilling and Remarks:

**Reported**

**C S L S E S E**

**RECORD**

Cased \_\_\_\_\_ in., \_\_\_\_\_ ft.

Sand \_\_\_\_\_

Gas \_\_\_\_\_

Oil \_\_\_\_\_

Total Depth \_\_\_\_\_

**PRODUCTION**

1st 24 hrs. Nat. \_\_\_\_\_

1st 24 hrs. after shot \_\_\_\_\_

Gas \_\_\_\_\_ Cu. Ft.

Dry Hole \_\_\_\_\_

Abandoned \_\_\_\_\_

Date

JUN 4 1941 19

S. J. LEWIS Scout