

26-4-18W
PI
JUL

LAUGHLIN-SIMMONS & CO. OF KANSAS, INC.
OIL FIELD SURVEYING
1337 NORTH MERIDIAN, SUITE 2 WICHITA, KANSAS 67203
(316) 943-5351

KW8038112

INVOICE NO.

Viking Energy Management

1

E. E. Quanz

OPERATOR

NO.

FARM

Phillips

26 4s 18w

2130' FNL 2370' FNL Sec.

COUNTY

S T R

LOCATION

Viking Energy Management
2700 Center Building
2761 East Skelly Drive
Tulsa, Oklahoma 74105

REC'D. ACCT. 1725 DF

AUG 7 1981

APPROVED

REURNED

NOTED OK


PHONE #

Handy Waychoff

AUTHORIZED BY:

verify this week

SCALE: 1/2" = 1 MILE

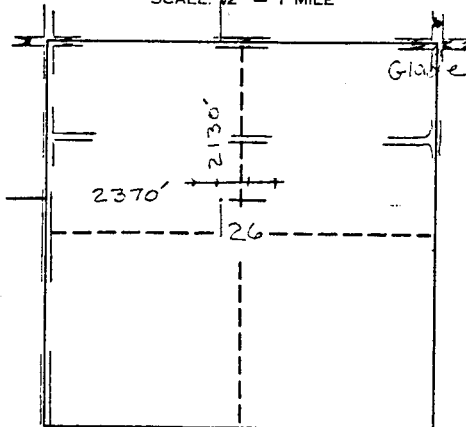

Ran routine Staking
procedure to verify
location.

FLAG

8/4/81

DATE

JF

cc:Waychoff

601

TOTAL \$150.00