


Section 10 Township 4 Range 18W

Well No. #1 Emerick

Company National Assoc.

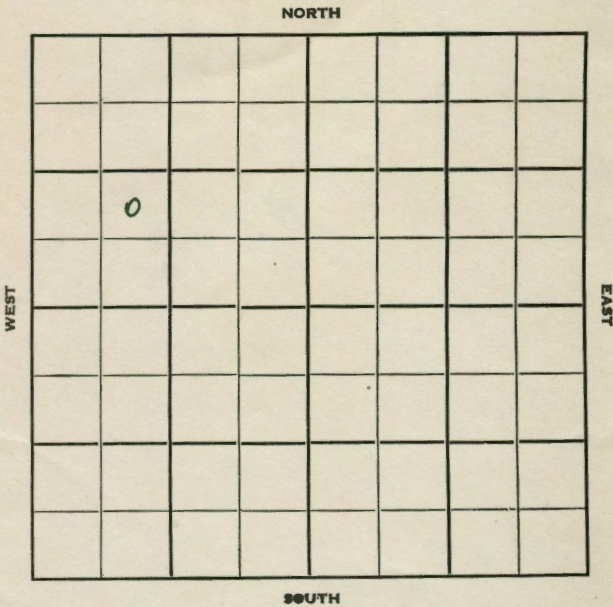

5

Section 10 Township 4 Range 18W

Well No. #1 Emerick Farm

National Assoc. Company

Ferrell- Contr. Contractor
Wildcat


..... Ft. from N. Line

990' Ft. from S. Line

..... Ft. from E. Line

990' Ft. from W. Line

NE SW NW

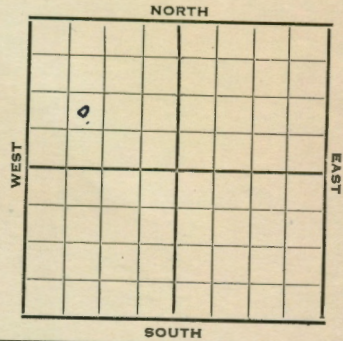

1951 Elev. 1894' REPORT

11/28 RUR

12/19 Spud 11-28-51
D&A TD 3600
8" @ 217

Top 2903 Hee b. 3109
Lans. 3136 Arb. 3576
TD 3600
D&A

ABANDONED

