


Section 32 Township 4 Range 18W

Well No. 1 Ashcraft

Company Iron Drlg.

Wildcat  
NORTH

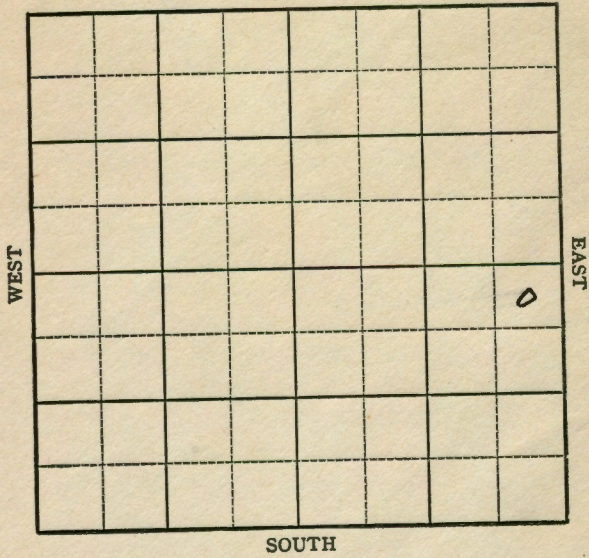

SOUTH

9

Sec. 32 Twp. 4 R. 18-W

Well No. #1 Ashcraft Farm

Iron Drlg. Company


Wildcat

330 Ft. from N. Line

\_\_\_\_\_ Ft. from S. Line

330 Ft. from E. Line

\_\_\_\_\_ Ft. from W. Line

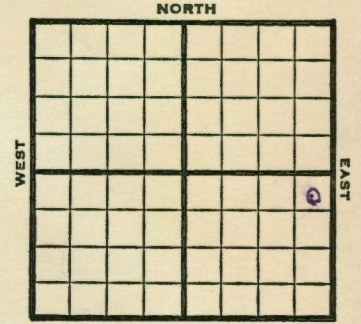

NE SE

SOUTH

1948 **Eli 1853'** REPORT

11/3 RUR

10/11 Drlg. 1530'

11/16 **Lansing 3052'** 13" @ 122'

**Arbuckle 3418'**

Drlg. 3440'

11/23 TDT 3472'

**Arb. 3418'**

Aband.

**ABANDONED**

Map No. 132 Sec. 32 Twp. 4 R. 18W

Well No. 1 Ashcraft

Iron Drlg. Company

**ABANDONED**

Contractor

NE SE

E. J. 1963

**SECTION PLAT**

330 Ft. from N. Line

\_\_\_\_\_ Ft. from S. Line

330 Ft. from E. Line

\_\_\_\_\_ Ft. from W. Line

			0

Phillips County

Location \_\_\_\_\_

**RECORD**

Cased \_\_\_\_\_ in., \_\_\_\_\_ ft.

Rig up \_\_\_\_\_

Sand \_\_\_\_\_

Drilling and Remarks:

Gas \_\_\_\_\_

Oil 3472

Oil \_\_\_\_\_

Total Depth 3472

**PRODUCTION**

1st 24 hrs. Nat. \_\_\_\_\_

1st 24 hrs. after shot \_\_\_\_\_

Gas \_\_\_\_\_ Cu. Ft.

Dry Hole \_\_\_\_\_

Abandoned \_\_\_\_\_

Date

NOV 23 1948 19

S. J. LEWIS Scout

Map No. \_\_\_\_\_ Sec. 32 Twp. 4 R. 18W

Well No. 1 Ashcraft

Iron Drlg. Company

**FIRST REPORT**

Contractor

NE SE

**SECTION PLAT**

330 Ft. from N. Line

\_\_\_\_\_ Ft. from S. Line

330 Ft. from E. Line

\_\_\_\_\_ Ft. from W. Line

			0

Phillips County

Location \_\_\_\_\_

**RECORD**

Cased \_\_\_\_\_ in., \_\_\_\_\_ ft.

Rig up \_\_\_\_\_

Sand \_\_\_\_\_

Drilling and Remarks:

Gas \_\_\_\_\_

R U R

Oil \_\_\_\_\_

Total Depth \_\_\_\_\_

**PRODUCTION**

1st 24 hrs. Nat. \_\_\_\_\_

1st 24 hrs. after shot \_\_\_\_\_

Gas \_\_\_\_\_ Cu. Ft.

Dry Hole \_\_\_\_\_

Abandoned \_\_\_\_\_

Date

NOV 3 1948 19

S. J. LEWIS Scout