


Section 1 Township 4 Range 19W

Well No. 2 Krause

Company Sohio Petr.

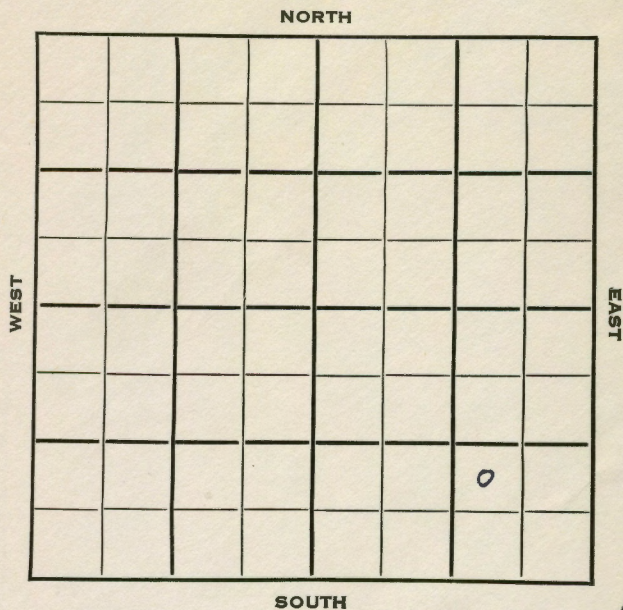

16

SEC. <u>1</u>	TWP. <u>4</u>	R. <u>19W</u>
---------------	---------------	---------------

WELL NO. #2 Krause FARM

COMPANY Sohio Pet.

CONTRACTOR Bill Hay


Mont-Sol Pool

_____ Ft. from N. Line

990 _____ Ft. from S. Line

990 _____ Ft. from E. Line

_____ Ft. from W. Line

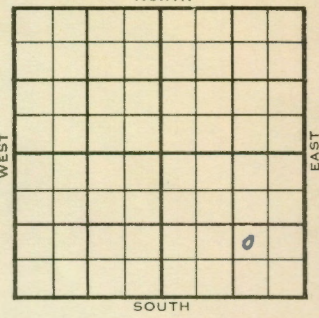

NW SE SE

1954	ELEVATION <u>1975'</u>	REPORT
------	---------------------------	--------

4/21 Spud 4-17-54
 Anhy 1515'
 Drlg 2030'

6/15 Spud 4-17-54 - Oil Well
 TD 3600'
 Anhy 1515'
 8" @ 307', ~~Ft. Riley 2035'~~
 Ft. Riley ~~XXX~~ 2035', Top 2949',
 Heeb 3147', Tor 3176', Mans 3184',
 B KC 3409', Marm. 3441', Cong 3529',
 Arb. 3556'
 TD 3600'
 5" @ 3398'
 64/3346-52, 1000A
 S/3½ bfpw 37% wtr., 4 hrs.,
 SP 3330, 32/3286-94, S/2½ bfpw
 3 hrs., 16% wtr, 1000A
 S/5 bfpw 16% wtr., 10 hrs.
 CO to 3364'
 Comp. 110 bopd 12% wtr.

COMPLETED

