


Section 3 Township 4 Range 19WWell No. 1 Beckman "A"Company CRA & North American Prod.

NORTH

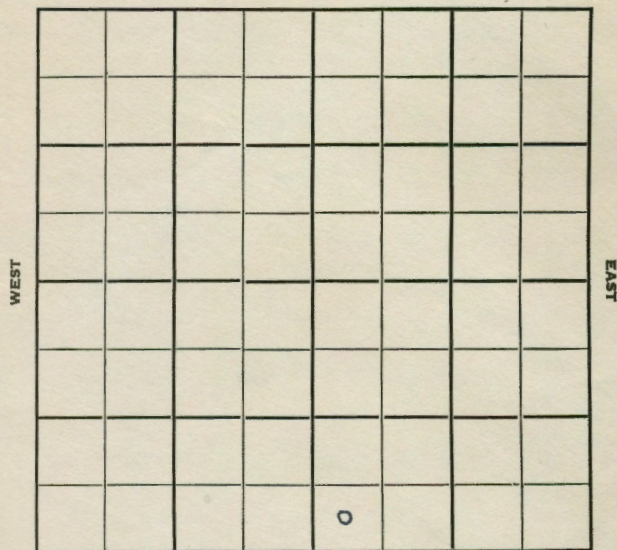

SOUTH

15

Sec. 3 Twp. 4 R. 19 W ✓Well No. # 1 Beckman "A" Farm

CRA & North American Prod. Company

Wildcat Contractor


Ft. from N. Line

330 Ft. from S. Line

Ft. from E. Line

330 Ft. from W. LineSW SW SE
CSO & Phillips DHM

NORTH

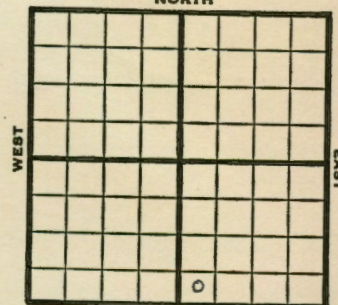

SOUTH

1951

Elev. 2013'

REPORT

7/25

Location

10/31

Spud 7-28-51

Oil Well TD 3528

8" @ 180

Top 2925 Heeb. 3125 Tor. 3149

Lans. 3166

DST 3186-3210 open 1 hr.

Rec. 45' OCM 15' free oil

DST 3225-61 open 1/2 hr.

Rec. 22' HOCM

Arb. 3500-03

5" @ 3501' TD 3528

FU 250' wtr. SP 3450 12/ 3243-47

5 BOPH 50% wtr. 1000 A S/ 8 BF

6 hr. 20% wtr. 2000 A S/ 14 1/2 BF

3 1/2 hr. SP 3229 6/ 3220-22

B/ 30 GO 2 hr. 3500 A S/ 4 BFPH

SP 3212 6/ 3201-03 6/ 3206-08

S/ 1-1/3 BFPH 6000 A S/ 9 BO

1 1/2 hr. DP 3450 S/ 1 BOPH 8 hr.

P/ 25 BF 23 hr. P/ 16 1/2 BO 14 BW

8 hr.

Comp. 22 BOPD

COMPLETED

County	Phillips	State	Kansas
Sec.	3 (Blk.) Twp.)	4 (Sur. Rge.)	19W Map No.
Operator	CRA & North American Prod.		
Well No.	1	Farm	Beckman "A"
Elev.	2013	Location	SW SW SE

COMPLETE	330 Ft. From S Line SE 330 Ft. From W Line Quarter Ist. Report Completion OCT 31 1951 Remarks Wildecat Spudding Date 7-28-51
----------	---

Drig. Data	Oil well	TD 3528
8" @ 180	Top. 2925	Heeb. 3125
Tor. 3149	Lans. 3166	DST 3186-3210
open 1 hr.	Rec. 45' ocm	15' free oil
DST 3225-61	open $\frac{1}{2}$ hr.	Rec. 22' ho cm
Arb. 3500-03	5" @ 3501	TD 3528
FU 250' water	SP 3450	12/ 3243-47
5 goph	50% water	1000 A S/ 8 bf 6 hr
20% water	2000 A	S/ 14 $\frac{1}{2}$ bf 3 $\frac{1}{2}$ hr.
SP 3229	6. 3220-22	B/ 30 go 2 hr.
3500 A	S/ 4 b fph	SP 3212 6/ 3201-03
6/ 3206-08	S/ 1 1/3 b fph	6000 A
S/ 9 bo	1 $\frac{1}{2}$ hr.	DP 3450 S/ 1 boph 8 hr
P/ 25 bf	23 hr	P/ 16 $\frac{1}{2}$ bo 14 bw 8 hr.
Comp. 22 bopd		

J. E. TYRA

County Phillips State Kansas

Sec. 8 (Blk. 4) (Twp. 19W) Map No.

Operator CRA & North American Prod.

Well No. 1 Farm Beekman "A"

Elev. Location SW SW SE

330 Ft. From S Line SE

330 Ft. From W Line Quarter

1st. Report JUL 25 1951

Completion

Remarks CSO & Phillips -DM

Spudding Date

Drlg. Data Wildcat

Location

J. E. TYRA