

KANSAS

Phillips

KANSAS


Phillips County

Sec. 8 Twp. 4 R. 19W

Section 8 Township 4 Range 19-W

Well No. #1 Baird

Company Helmerich & Payne

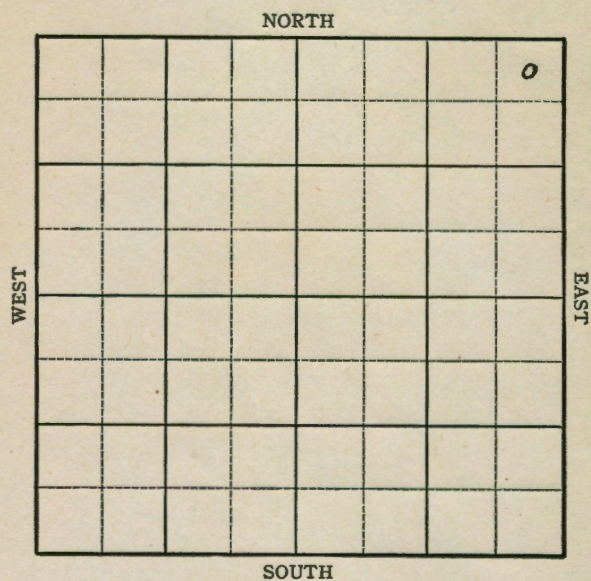

Well No. #1 Baird Farm

Helmerich & Payne Company


Wilcoat

330 Ft. from N. Line

Ft. from S. Line

330 Ft. from E. Line

Ft. from W. Line

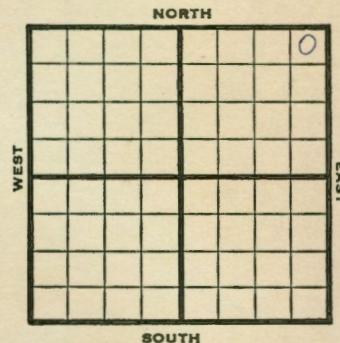

NE/c

1946

Elev. 2060

REPORT

3/13 RUR
 3/21 10" - 160' Anhy 1590'
 Drlg. 2450'
 3/28 Lans. 3249' Arb. 3594'
 Drlg. 3616'

4/3

Reagan 3918
 Granite Wash 3938
 TD 3965'

ABANDONED

KANSAS Kansas Pool Name WildcatMap No. 133 Sec. 8 Twp. 4 R. 19WWell No. 1 BairdHelmerich & Payne Company

ABANDONED

Contractor

NE/C


SECTION PLAT

330 Ft. from N. Line

Ft. from S. Line

330 Ft. from E. Line

Ft. from W. Line

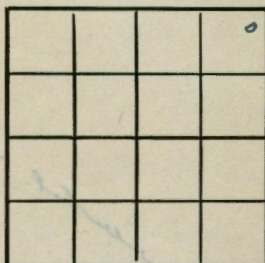

Phillips County

Location

Rig up

Drilling and Remarks:

*Reagan 8918**Granite Wash 8988*

RECORD

Cased in, ft.

Sand

Gas

Oil

Total Depth 2965

PRODUCTION

1st 24 hrs. Nat.

1st 24 hrs. after shot

Gas Cu. Ft.

Dry Hole

Abandoned

Date

APR 3 1946

19

S. J. LEWIS

Scout

KANSAS Kansas Pool Name WildcatMap No. 133 Sec. 8 Twp. 4 R. 19WWell No. 1 BairdHelmerich & Payne Company

FIRST REPORT

Contractor

NE /C


SECTION PLAT

330 Ft. from N. Line

Ft. from S. Line

330 Ft. from E. Line

Ft. from W. Line

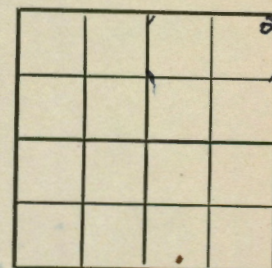

Phillips County

Location

Rig up

Drilling and Remarks:

R U R

RECORD

Cased in, ft.

Sand

Gas

Oil

Total Depth

PRODUCTION

1st 24 hrs. Nat.

1st 24 hrs. after shot

Gas Cu. Ft.

Dry Hole

Abandoned

Date

MAR 13 1946

19

S. J. LEWIS Scout