


Section 12 Township 4 Range 19W

Well No. #1 Sophie Meyer

Company Sohio Pet.

NORTH

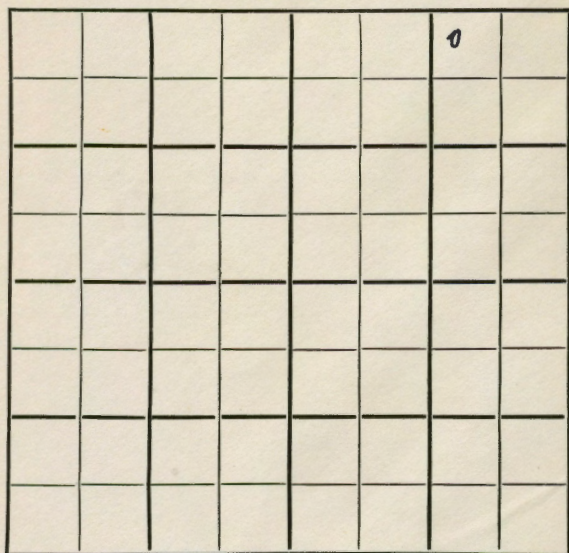

SOUTH

SEC. 12 TWP. 4 R. 19W

WELL NO. #1 Sophie Meyer FARM

COMPANY Sohio Pet.

CONTRACTOR Bill Hay


330 Ft. from N. Line

Ft. from S. Line

990 Ft. from E. Line

Ft. from W. Line

NW NE NE

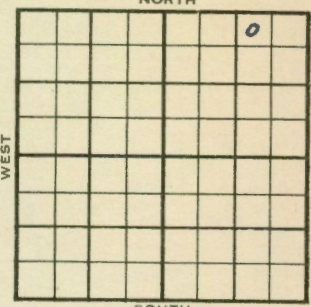

1954 ELEVATION 1998' REPORT

4/7 Spud 4-5-54
8" @ 309'
WOC.

4/14 WOC

5/12 Spud 4-5-54 Dil well TD 3619
8" @ 309 Anhy 1552 Top 2971
Heeb 3170 Tor. 3194 Lans 3206
DST 3234-54, open 1 hr rec 662' gas.
411' free oil, 10' MCO 220#
B KC 3429 Marm. 3462 Cong. 3541
Arb. 3551 TD 3619 5" @ 3409
CO to 3374 24/3246-52 1000 A
S/10 BFPH 8% wtr. 9 hr.
Comp. 321 BOPD 2% wtr.

COMPLETED

