


Section 16 Township 4 Range 19W
 Well No. 1 Bales
 Company Jones, Shelburne & Farmer

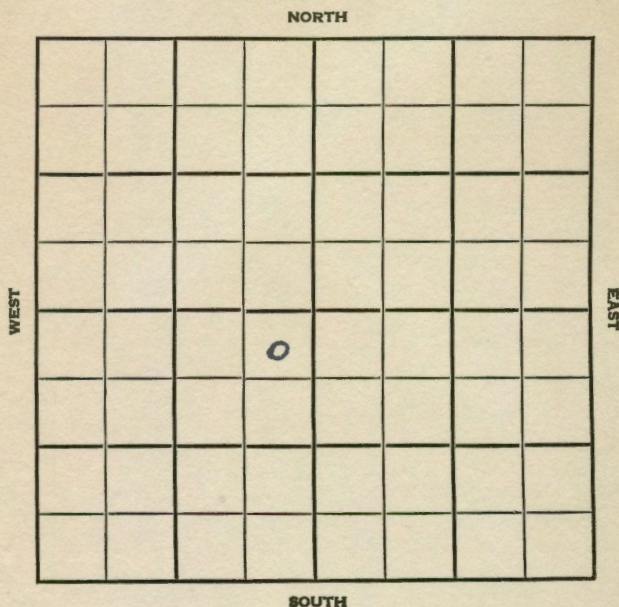

11

SEC. 16 TWP. 4 R. 19 W
 WELL NO. # 1 Bales
 COMPANY Jones, Shelburne & Farmer FARM
 CONTRACTOR

Co. tools
 Wildcat


330 Ft. from N. Line

Ft. from S. Line

330 Ft. from E. Line

Ft. from W. Line

NE NE SW
 CSO - FO & DHM

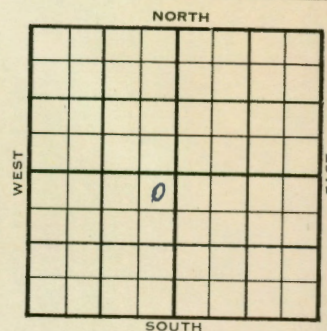

1954 ELEVATION 2006' REPORT

10/20 Location

12/8 Spud 10-20-54

Oil Well

TD 3607'

8" @ 160'

Anhy 1532' Heeb 3169' Tor 3196' Lans 3210'

DST 3213'-20' opn 1 hr, rec 90' gas, 83' oil, 2' Mud, 1050#

DST 3236'-51' opn 1 hr, rec 8' Mud 1' free oil, 60#

DST 3254'-66' opn 1 hr, rec 4' Mud 350#

DST 3273'-3310' opn 1 hr, rec 20' hocm 1160#

DST 3382'-3410' opn 1/2 hr, rec 4' socm 200#

TD 3606'

5" @ 3414'

B KC 3414', Arb. 3592'

DD 3607' 16/ 3382-86 1000 A 7 go


7 gw. PB 20/ 3307-12 1000 A 3 go

30 gw PB 8/ 3291-93 1000 A 2.61

bfph 90% Wtr. PB 8/ 3212-14 1000 A S/ 3 1/2 boph S/ 2 1/2 boph 24 hr.

Comp 20 bopd.

County **Phillips** State **Kansas**
 Sec. **16** (Blk. Twp.) **4** (Sur. Rge.) **19W** Map No.
 Operator **Jones, Shelburne & Farmer**
 Well No. **1** Farm **Bales**
 Elev. **2006** Location **NE NE SW**

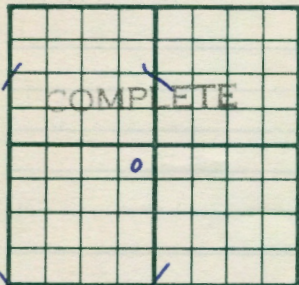

330 Ft. From **N** Line **SW**
330 Ft. From **E** Line Quarter
 Ist. Report
 Completion **DEC 8 1954**
 Remarks **Wildcat**
Co. tools
 Spudding Date **10-20-54**

Drlg. Data **Oil well TD 3607**
8" @ 160 Anhy 1532 Heeb. 3169
Tor. 3196 Lans. 3210 DST 3213-20
open 1 hr. Rec. 90' gas 83' oil
2' mud 1050# DST 3236-51 open 1 hr.
Rec. 8' mud 1' free oil 60#
DST 3254-66 open 1 hr. Rec. 4' mud
350# DST 3273-3310 open 1 hr. Rec.
20' hocom 1160# DST 3382-3410 open
 $\frac{1}{2}$ hr. Rec. 4' socm 200# TD 3606
5" @ 3414 B KC 3414 Arb. 3592
DD 3607 16/ 3382-86 1000 A 7 go
7 gw PB 20/ 3307-12 1000 A
3 go 30 gw PB 8/ 3291-93 1000 A
2.61 bfph 90% wtr. PB 8/ 3212-14

FABEN GILSTRAP

County **Phillips** State **Kansas**
 Sec. **16** (Blk. Twp.) **4** (Sur. Rge.) **19W** Map No.
 Operator **Jones, Shelburne & Farmer**
 Well No. **1** Farm **Bales**
 Elev. Location **NE NE SW**



330 Ft. From **N** Line **SW**
330 Ft. From **E** Line Quarter
 Ist. Report **OCT 20 1954**
 Completion
 Remarks **CSO - FO & DDM**
Co. tools
 Spudding Date

Drlg. Data **Wildcat**
Location

FABEN GILSTRAP