


Map No. **KANSAS** Sec. 24 Twp. 4^S R. 2^W

Well No. 1-5000 Farm

Struter - Sawyer Company

NORTH

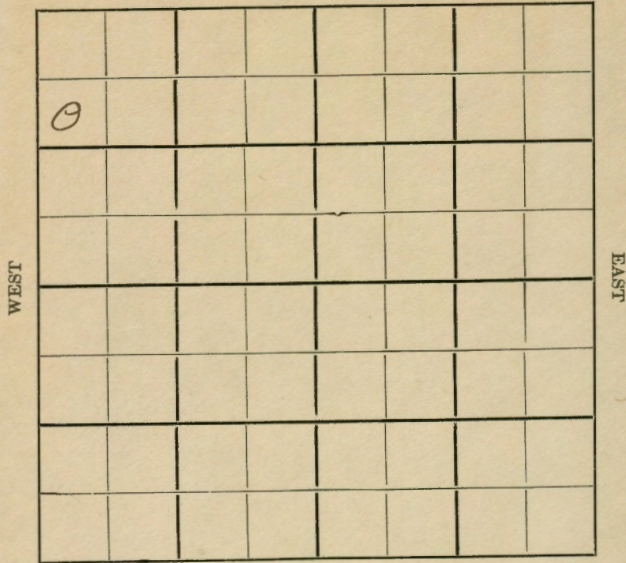

SOUTH

4

Location.....
Drilling Remarks.....

Rig Up.....
Drilling Remarks.....

RECORD

Cased..... in..... ft.
Sand.....
Gas.....
Oil.....
Total Depth.....

PRODUCTION

1st 24 hrs. Nat.....
1st 24 hrs. after shot.....
Gas..... cu. ft.....
Dry Hole.....
Abandoned.....


Map No. Sec. Twp. R.

Well No. Farm

Company

NORTH

..... Ft. from N. Line
..... Ft. from S. Line
..... Ft. from E. Line
..... Ft. from W. Line

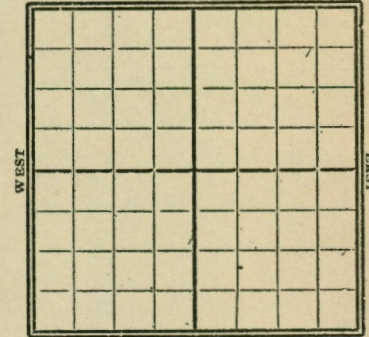

SOUTH

1923

Date

REPORT

Gypsy Records

Mar. Abd. TD 2710'

45

MAP No. _____ SEC. 24 TWP. 4S R. 2W

WELL No. 1 Center

Street, Sawyer + Stearns COMPANY

no well log CONTRACTOR

SECTION PLAT

0			

_____ FT. FROM N. LINE

_____ FT. FROM S. LINE

_____ FT. FROM E. LINE

_____ FT. FROM W. LINE

LOCATION _____

RIG UP _____

DRILLING AND REMARKS:

RECORD

CASED _____ IN. _____ FT.

SAND _____

GAS _____

OIL _____

TOTAL DEPTH 2710

PRODUCTION

1ST 24 HRS. NAT. _____

1ST 24 HRS. AFTER SHOT _____

GAS _____ CU. FT.

DRY HOLE

ABANDONED

DATE

May 1923 _____ SCOUT