


KANSAS

FORM 51 5M 4-41 PETROL

Phillips

Section 24 Township 4- Range 20-W
 Well No. 1 Lynch Estate
 Company Lario Oil & Gas

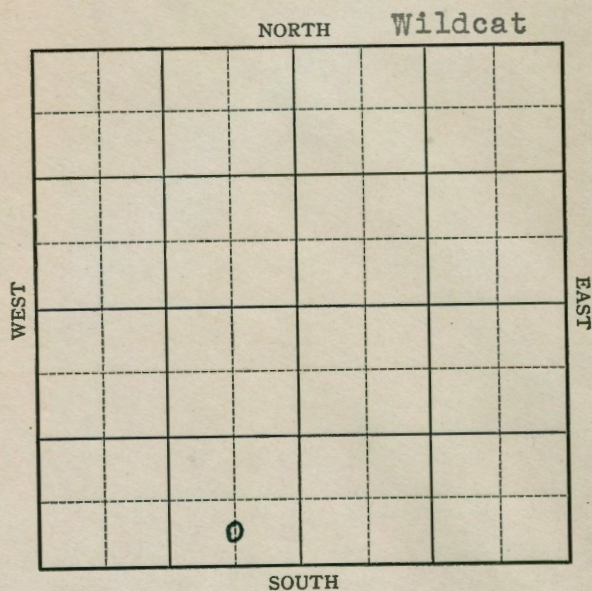

14

FORM 252-A 5M 1-41 PETROL


KANSAS

Phillips

Sec. 24 Twp. 4 R. 20-W
 Well No. #1 Lynch Estate Farm
Lario Oil & Gas Company
 (Wildcat)

 Ft. from N. Line
330 Ft. from S. Line
660 Ft. from E. Line
 Ft. from W. Line

Elev. 2018

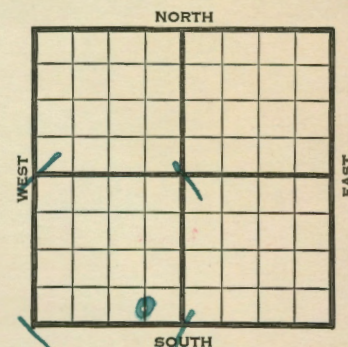


1941	REPORT
5/27	Derrick.
6/5	Rotary.
6/12	8" - 184' Anhy. 1543' Drlg. 1890'
6/19	Topeka 2935' Lans. 3161' S.O. 3175-80 & 3250' Coring.
6/26	Arb. 3407' Coring 3447'
7/3	Basal Sand 3812' Granite 3843' T.D. 3848' 5" - 3355' S.D.
7/10	48 shots 3246½-59' 18 " 3318-21' 1000 acid. 15 bbls. water, S.O. in 2 hours.
7/17	Swab 1½ BO & 45 bbls. Water a day. Squeeze off perforations.
7/24	PB 3281 swb 5 fluid PH 5 hrs. SD
7/30	Arb 3470 Basal Sand 3812 Granite 3843 TD 3848' 5" @ 3355' water.
	ABANDONED

Map No. 133 Sec. 24 Twp. 4 R. 20WWell No. 1 Lynch EstateLario Oil & Gas Company
ABANDONED Contractor

C S L SE SW

SECTION PLAT

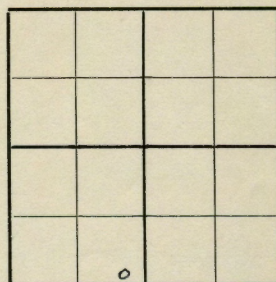

Ft. from N. Line

330 Ft. from S. Line660 Ft. from E. Line

Ft. from W. Line

WILDCAT

Location

Rig up

Drilling and Remarks:

Cr 83470
Basal Sol 3842
Granite 3843
5" @ 3355
Water.

RECORD

Cased in., ft.
 Sand
 Gas
 Oil
 Total Depth 3848

PRODUCTION

1st 24 hrs. Nat.
 1st 24 hrs. after shot
 Gas Cu. Ft.
 Dry Hole
 Abandoned

Date

JUL 30 1941 19

S. J. LEWIS Scout

Map No. 133 Sec. 24 Twp. 4 R. 20WWell No. 1 Lynch Estate

Lario Oil & Gas Company

FIRST REPORT Contractor

SECTION PLAT


C S L SE SW

Ft. from N. Line

330 Ft. from S. Line660 Ft. from E. Line

Ft. from W. Line

WILDCAT

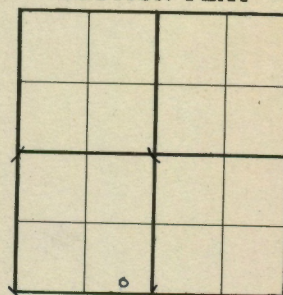

Location

Rig up

Drilling and Remarks:

Derrick

RECORD

Cased in., ft.
 Sand
 Gas
 Oil
 Total Depth

PRODUCTION

1st 24 hrs. Nat.
 1st 24 hrs. after shot
 Gas Cu. Ft.
 Dry Hole
 Abandoned

Date

MAY 27 1941 19

S. J. LEWIS Scout