


KANSAS

Phillips County

Section 15 Township 4 Range 20-WWell No. 1 FoxCompany Tom Palmer

Wildcat

NORTH

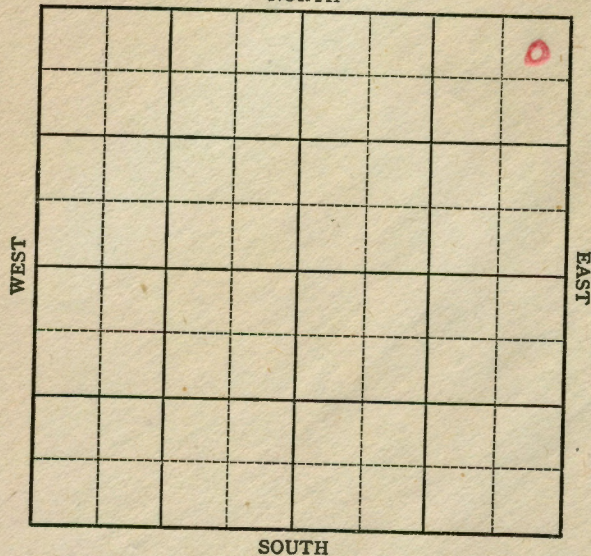

KANSAS

Phillips

Sec. 15 Twp. 4 R. 20-WWell No. #1 Fox Farm

Tom Palmer

Company

Wildcat
330


Ft. from N. Line

Ft. from S. Line

330

Ft. from E. Line

Ft. from W. Line

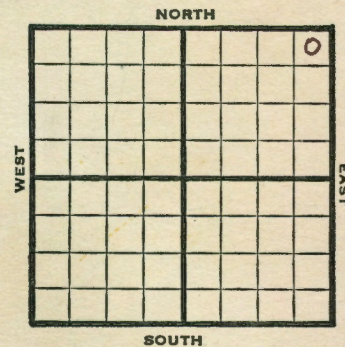

NE/C

1947

Elev 2078' REPORT

7/2

R UR

7/8

8" @ 175'

Dr1g 400'

7/16

Lansing 3266'

Arbuckle 3616'

T.D. 3645'

Abandoned

ABANDONED

Map No. 133 Sec. 15 Twp. 4 R. 20WWell No. 1 Fox

Tom Palmer

Company

ABANDONED

Contractor

NE/C


SECTION PLAT

330 Ft. from N. Line

Ft. from S. Line

330 Ft. from E. Line

Ft. from W. Line

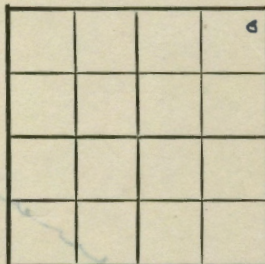

Phillips County

Location

Rig up

Drilling and Remarks:

Same 3266QY 3616

RECORD

Cased _____ in., _____ ft.

Sand _____

Gas _____

Oil _____

Total Depth 3645

PRODUCTION

1st 24 hrs. Nat. _____

1st 24 hrs. after shot _____

Gas _____ Cu. Ft.

Dry Hole _____

Abandoned _____

Date

JUL 16 1947 19S. J. LEWIS ScoutMap No. _____ Sec. 15 Twp. 4 R. 20WWell No. 1 Fox

Tom Palmer

Company

FIRST REPORT

Contractor

NE/C


SECTION PLAT

330 Ft. from N. Line

Ft. from S. Line

330 Ft. from E. Line

Ft. from W. Line

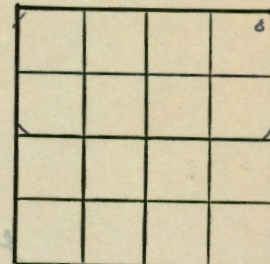

Phillips County

Location

Rig up

Drilling and Remarks:

R U R

RECORD

Cased _____ in., _____ ft.

Sand _____

Gas _____

Oil _____

Total Depth _____

PRODUCTION

1st 24 hrs. Nat. _____

1st 24 hrs. after shot _____

Gas _____ Cu. Ft.

Dry Hole _____

Abandoned _____

Date

JUL 2 1947 19S. J. LEWIS Scout