


Phillips

KANSAS

SECTION 19 TOWNSHIP 4 RANGE 20 WWELL NO. #1 NoelCOMPANY Anschutz Drlg.

NORTH

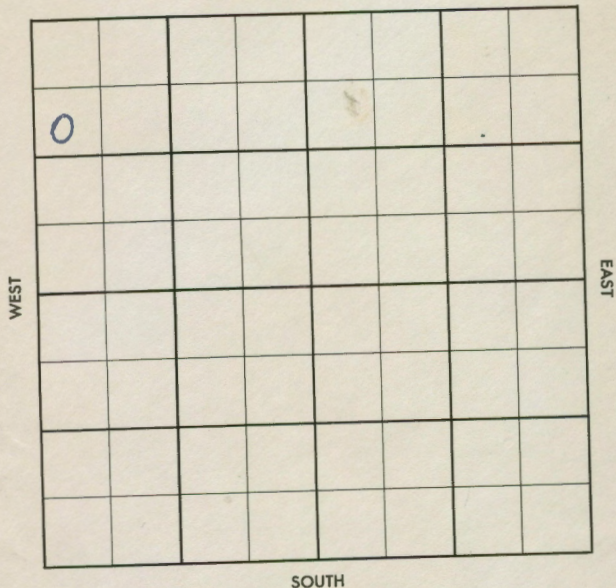

SOUTH

4

SEC.

19

TWP.

4

R.

20W

WELL NO.

#1 Noel

FARM

COMPANY

Anschutz Drlg.

CONTRACTOR

Co. tools

WILDCAT

Ft. from N. Line


Ft. from S. Line

Ft. from E. Line

Ft. from W. Line

SW NW NW

NORTH

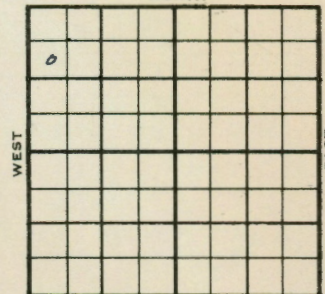

SOUTH

NCRA support

1955

ELEVATION

2093'

REPORT

11-23

Comm. 11-21-55

8" @ 234/275

WOC

12-7

DST 3487-3507 op 1 hr. rec. 30' mud

0/30"

D & A

Anh. 1728

H. 3299

Tr. 3324

L. 3342

BKC 3544

C. 3635

A. 3656

TD 3687'

ABANDONED

County	Phillips	Elev.	
Sec.	19	Twp.	4
Rge.	20W		
Company	Anschutz Drlg.		
FarmName	Noel	No.	1

TOPS	DEPTH	LOG	DATUM	Loc. in Sec.
Anh.				SW NW NW
Tr.				
H.				
Tr.				
Dg.				
Bl.				
L.				
K.C.				Geol.
B.K.C.				Contr.
Ce.				Co. tools
C.				
M.				Pool
M.				Wildcat
K.				
Mz.				
Mq.				
V.				
S.				
S.				
A				
R.				
Pe.				
G.				
T.D.				

Date Comm. 11-21-55 NCRA support

8" @ 234/275 WOC

County	Phillips	Elev.	2093
Sec.	19	Twp.	4
Rge.	20W		
Company	Anschutz Drlg.		
FarmName	Noel	No.	1

TOPS	DEPTH	LOG	DATUM	Loc. in Sec.
Anh.	1728			SW NW NW
Tr.				
H.	3299		1206	
Tr.	3324		1231	
Dg.				
Bl.				
L.	3342		1247	
K.C.				Geol.
B.K.C.	3544		1451	Contr.
Ce.				Co. tools
C.	3635		1542	
M.				Pool
M.				Wildcat
K.				
Mz.				
Mq.				
V.				
S.				
S.				
A	3656		1563	
R.				
Pe.				
G.				
T.D.	3687			

Date Comm. 11-21-55

8" @ 234/275 DST 3487-3507 open 1 hr.

rec. 30' mud 0/30"

D & A

ABANDONED