


Section 25 Township 4 Range 20W

Well No. #1 Donahey

Company Cities Service & Lario

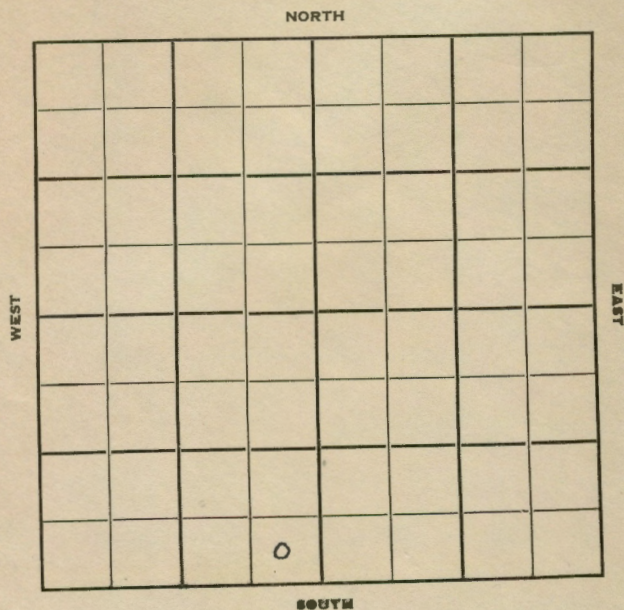


14

Sec. 25 Twp. 4 R. 20 W
 Well No. # 1 Donahey Farm
 Cities Service & Lario Company
 Rine Drlg. Contractor
 Stinker Pool

Ft. from N. Line
330 Ft. from S. Line
330 Ft. from E. Line
 Ft. from W. Line


SE SE SW

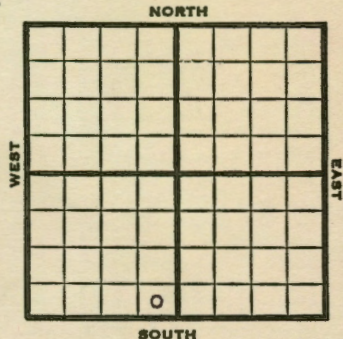

1951	Elev. 1951'	REPORT
8/8	Location	
10/17	Spud 9-8-51 Oil Well TD 3340 8" @ 200 Anhy 1450 Dodge 3098 DST 3133-65 opn 1 hr DST 3180-3221 opn 1 hr DST 3322-39 opn 1 hr BKC 3324 TD 3340 5" @ 3340 CO to 3303 80/3184-3208 2000 A 34/3236-45 1000 A 33/3144-54 1000 A 8 hr. Comp. 11 bopd 16 bw	Heeb. 3070 Lans. 3114 Rec. 30' socm Rec. 7' mud Rec. 7' socm P/9 bo 6 bwpd P/25 go 5 gwph P/1-2/3 bo 80 bw P/12 bo 18 bwpd

COMPLETED

County Phillips State Kansas
 Sec. 25 (Blk. 4 (Sur. 20W Map No.
 (Twp.) (Rge.)
 Operator Cities Service & Lario
 Well No. 1 Farm Donahey
 Elev. 1951 Location SE SE SW

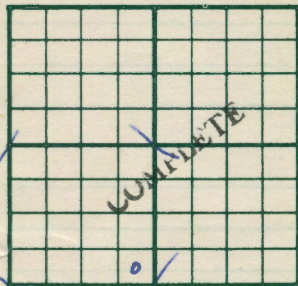

330 Ft. From S Line SW
 330 Ft. From E Line Quarter
 1st. Report
 Completion OCT 17 1951
 Remarks Stinker Pool
Rine Drlg. - Contr.
 Spudding Date 8-8-51

Drlg. Data Oil well TD 3340
8" @ 200 Anhy 1450 Heeb. 3070
Dodge 3098 Lans. 3114 DST 3133-65
open 1 hr. Rec. 30' socm DST 3180-3221
open 1 hr. Rec. 7' mud DST 3322-393
open 1 hr. Rec. 7' socm B KC 3324
TD 3340 5" @ 3340 CO to 3303
80/ 3184-3208 2000 A P/ 9 bo 6 bwpd
34/ 3236-45 1000 A P/ 25 go 5 gwph
33/ 3144-54 1000 A P/ 1 2/3 bo 80 bw
8 hr. P/ 12 bo 18 bwpd
Comp. 11 bopd 16 bw

J. E. TYRA

County Phillips State Kansas
 Sec. 25 (Blk. 4 (Sur. 20W Map No.
 (Twp.) (Rge.)
 Operator Cities Service & Lario
 Well No. 1 Farm Donahey
 Elev. Location SE SE SW



330 Ft. From S Line SW
 330 Ft. From E Line Quarter
 1st. Report AUG 8 1951
 Completion
 Remarks
Rine Drlg. - Contr.
 Spudding Date

Drlg. Data Stinker Pool

Location

J. E. TYRA