


Section 26 Township 4 Range 20 W

Well No. # 1 Baldwin

Company D. G. Hanson & C & G Drlg.

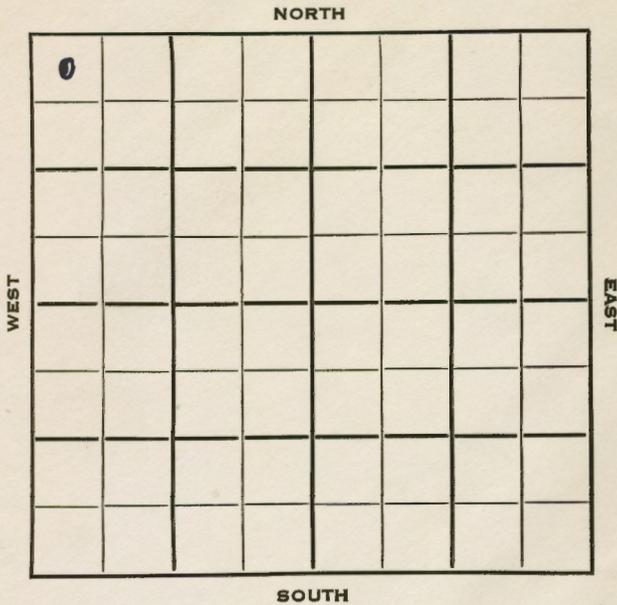

4

Sec. 26 Twp. 4 R. 20W

Well No. #1 Baldwin Farm

D. G. Hanson & C & G Drlg. Company

C & G Drlg. Contractor


330 Ft. from N. Line

Ft. from S. Line

Ft. from E. Line

330 Ft. from W. Line

Tidewater, CSO & Sun Support NW NW NW

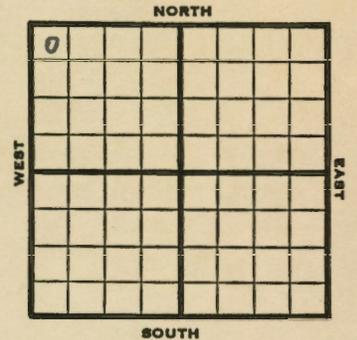

1953 Elev. 2018' REPORT

8/5 Cellar & Pits
 8/12 Spud 8-5-53 D & A TD 3530'
 8" @ 166 Anhy 1565' Heeb 3144'
 Tor. 3170' Lans 3188
 DST 3246-76 open 1 hr rec 24' mud
 1080# B KC 3387' Cong 3476'
 EroArb. 3486' Arb. 3495'
 TD 3530'
 D & A

ABANDONED.

County Phillips State Kansas
 Sec. 26 (Blk. 4) (Sur. 20W) Map No.
 Operator D. G. Hanson & C & G Drlg.
 Well No. 1 Farm Baldwin
 Elev. 2018 Location NW NW NW

0				

330 Ft. From N Line NW
330 Ft. From W Line Quarter
 Ist. Report
 Completion AUG 12 1953
 Remarks Wildcat
C & G Drlg. - Contr.
 Spudding Date 8-5-53

Drlg. Data D & A TD 3530
8" @ 166 Anky 1565 Heeb. 3144
Tor. 3170 Lans. 3188 DST 3246-76
open 1 hr. Rec. 24' mud 1080# B KC 3387
Cong. 3476 EroArb. 3486 Arb. 3496
TD 3530

D & A

J. G. McGEHEE

County Phillips State Kansas
 Sec. 26 (Blk. 4) (Sur. 20W) Map No.
 Operator D. G. Hanson & C & G Drlg.
 Well No. 1 Farm Baldwin
 Elev. Location NW NW NW

0				

330 Ft. From N Line NW
330 Ft. From W Line Quarter
 Ist. Report 4UG 5 1953
 Completion
 Remarks Tidewater, CSO & Sun support
C & G Drlg. - Contr.
 Spudding Date

Drlg. Data Wildcat

Cellar & pits

J. G. McGEHEE