

Section 35 Township 4 Range 20W

Sec. 35 Twp. 4 R. 20W

Well No. #1 Rose

Well No. #1 Ross Farm

Company R. W. Rine Drlg. Co.

R. W. Rine Drlg. Co. Company

Contractor

Wildcat

..... Ft. from N. Line


330' Ft. from S. Line

330' Ft. from E. Line


..... Ft. from W. Line

SE SE NE

CSO - DHM

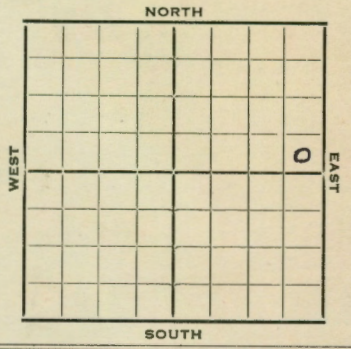

NORTH

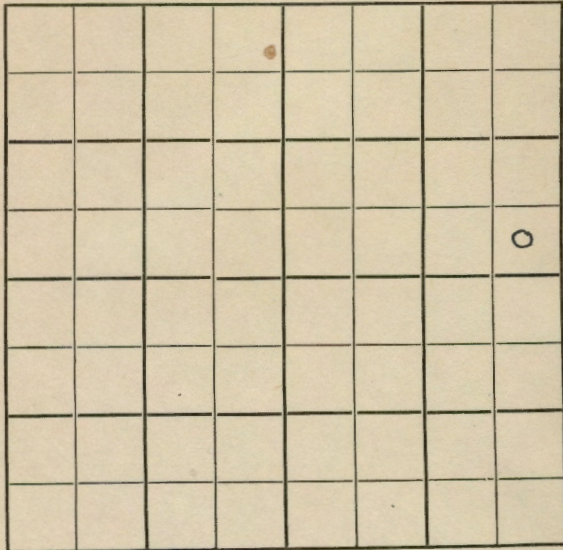

SOUTH

8

1952 **Elev. 1928'** REPORT

4/16 Spud 4-12-52
8" @ 244 w/175 sks
Drlg. 2190'

4/23 Spud 4-12-52
D&A TD 3450 8" @ 244
Heeb. 3045 Dodge 3071
DST 3060-81 open 1 hr. rec. 10' ocm
145' sw Lans. 3090
DST 3163-73 open 1 hr. Rec. 60' socm
DST 3175-89 open 1/2 hr. rec. 12' mud
B KC 3300 Re Arb. 3412 Arb. 3420
TD 3450 D&A

ABANDONED

County **Phillips** State **Kansas**
 Sec. **35** (Blk. **4**) (Sur. **20W**) Map No.
 Operator **R. W. Rine Drlg.**
 Well No. **1** Farm **Ross**
 Elev. **1928** Location **SE SE NE**

| | | | | | |
|--|--|--|--|--|--|
| | | | | | |
| | | | | | |
330 Ft. From **S** Line **NE**
330 Ft. From **E** Line **Quarter**

Ist. Report
 Completion **APR 23 1952**
 Remarks **Wildcat**

Spudding Date **4-12-52**

Drlg. Data **D & A TD 3450**
8" @ 244 Heeb. 3045 Dodge3071
DST 3060-81 open 1 hr. Rec. 10' ocm
145' sw Lans. 3090 DST 3163-73
open 1 hr. Rec. 60' socm DST 3175-89
open 1/2 hr. Rec. 12' mud B KC 3300
ReArb. 3412 Arb. 3420 TD 3450
D & A

J. G. McGEHEE

County **Phillips** State **Kansas**
 Sec. **35** (Blk. **4**) (Sur. **20W**) Map No.
 Operator **R. W. Rine Drlg. Co.**
 Well No. **1** Farm **Ross**
 Elev. Location **SE SE NE**

| | | | | | |
|--|--|--|--|--|--|
| | | | | | |
| | | | | | |
330 Ft. From **S** Line **NE**
330 Ft. From **E** Line **Quarter**
 Ist. Report **APR 16 1952**

Completion
 Remarks **CSO - IHM**

Spudding Date **4-12-52**

Drlg. Data **Wildcat**
8" @ 244 W/175 Drlg. 2190

J. G. McGEHEE