



FORM 51 25M 3-49 PETROL **Phillips** **KANSAS**
 Section 36 Township 4 Range 20W
 Well No. #1 O'Connell
 Company Rine Drlg.

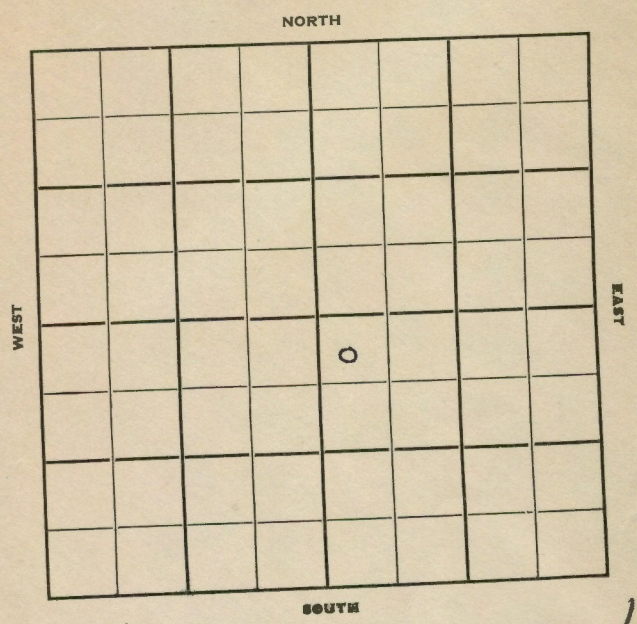

10

FORM 502-B
 10M 11-50 PETROL **Phillips** **KANSAS**
 Sec. 36 Twp. 4 R. 20 W
 Well No. # 1 O'Connell Farm
Rine Drlg. Company
Honaker Drlg. Contractor
Slinker Pool

330 Ft. from N. Line
 _____ Ft. from S. Line
 _____ Ft. from E. Line
330 Ft. from W. Line
 NW NW SE

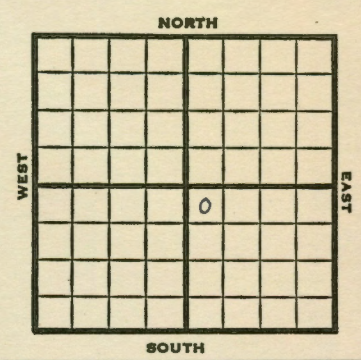

1951	Elev. 1929' REPORT
8/15	R U R
9/29	Spud 8-14-51 D&A TD 3574 8" @ 209 Anhy 1490-1535 KC 3175 DST 3184-94 opn 15 min. Rec. 2' socm DS 3246-56 opn 10 min. Rec. 4' vsocm DST 3278-55 opn 1/2 hr Rec. 3' vsocm Arb. 3524-74 TD D&A
	ABANDONED

