

KANSAS DRILLERS LOG

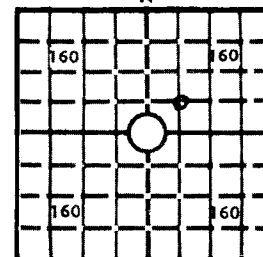
IMPORTANT
Kans. Geo. Survey request
samples on this well.

26-4-2W

S. 26 T. 4 R. 21 E

Loc. SW NE

County Norton

640 Acres
N

Locate well correctly

Elev.: Gr.

DF. KB

API No. 15 — 137 — 20,123
County Number

Operator

Jenkins Cil Co., Inc.

Address

Suite 411, 200 East First Wichita, Kansas 67202

Well No.

#1

Lease Name

Lutz-Wiltrout

Footage Location

1980 feet from (N) line 1980 feet from (E) line

Principal Contractor

Emphasis Oil Operations

Geologist

R.B. Jenkins

Spud Date

12-30-77

Total Depth

3625'

P.B.T.D.

Date Completed

1-5-78

Oil Purchaser

CASING RECORD

Report of all strings set — surface, intermediate, production, etc.

Purpose of string	Size hole drilled	Size casing set (in O.D.)	Weight lbs/ft.	Setting depth	Type cement	Sacks	Type and percent additives
Surface	12"	8-5/8		223'	common	175	2% gel, 3% cc

LINER RECORD

PERFORATION RECORD

Top, ft.	Bottom, ft.	Sacks cement	Shots per ft.	Size & type	Depth interval

Size	Setting depth	Packer set at			

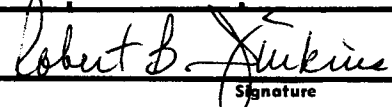
ACID, FRACTURE, SHOT, CEMENT SQUEEZE RECORD

Amount and kind of material used	Depth interval treated

INITIAL PRODUCTION

Date of first production	Producing method (flowing, pumping, gas lift, etc.)				
RATE OF PRODUCTION PER 24 HOURS	Oil	Gas	Water	Gas-oil ratio	
	bbls.	MCF	bbls.	CFPB	
Disposition of gas (vented, used on lease or sold)			Producing interval (s)		

INSTRUCTIONS: As provided in KCC Rule 82-2-125, within 90 days after completion of a well, one completed copy of this Drillers Log shall be transmitted to the State Geological Survey of Kansas, 4150 Monroe Street, Wichita, Kansas 67209. Copies of this form are available from the Conservation Division, State Corporation Commission, 3830 So. Meridian (P.O. Box 17027), Wichita, Kansas 66217. Phone AC 316-522-2206. If confidential custody is desired, please note Rule 82-2-125. Drillers Logs will be on open file in the Oil and Gas Division, State Geological Survey of Kansas, Lawrence, Kansas 66044.

Operator JINKINS OIL COMPANY, INC.		DESIGNATE TYPE OF COMP.: OIL, GAS, DRY HOLE, SWDW, ETC.: DRY HOLE																			
Well No. 1	Lease Name Lutz-Wiltrout																				
S 26 T 4 R 21 W																					
WELL LOG <small>Show all important zones of porosity and contents thereof; cored intervals, and all drill-stem tests, including depth interval tested, cushion used, time tool open, flowing and shut-in pressures, and recoveries.</small>		SHOW GEOLOGICAL MARKERS, LOGS RUN, OR OTHER DESCRIPTIVE INFORMATION.																			
FORMATION DESCRIPTION, CONTENTS, ETC.	TOP	BOTTOM	<table border="1" style="width: 100%; border-collapse: collapse;"> <thead> <tr> <th style="padding: 5px; text-align: center;">NAME</th> <th style="padding: 5px; text-align: center;">DEPTH</th> </tr> </thead> <tbody> <tr> <td style="padding: 5px;">Great Guns R.A. Guard Log</td> <td></td> </tr> <tr> <td style="padding: 5px;">Anhydrite</td> <td style="text-align: right; padding: 5px;">1728</td> </tr> <tr> <td style="padding: 5px;">Heebner</td> <td style="text-align: right; padding: 5px;">3293</td> </tr> <tr> <td style="padding: 5px;">Toronto</td> <td style="text-align: right; padding: 5px;">3322</td> </tr> <tr> <td style="padding: 5px;">Lansing</td> <td style="text-align: right; padding: 5px;">3338</td> </tr> <tr> <td style="padding: 5px;">Base Kansas City</td> <td style="text-align: right; padding: 5px;">3529</td> </tr> <tr> <td style="padding: 5px;">Arbuckle</td> <td style="text-align: right; padding: 5px;">3587</td> </tr> <tr> <td style="padding: 5px;">Total Depth</td> <td style="text-align: right; padding: 5px;">3621</td> </tr>
Surface sand and shale Shale Anhydrite Shale Lime and shale Shale and lime Lime and shale Lime	228 1731 1765 2800 3335 3515 3580 3625																				
USE ADDITIONAL SHEETS, IF NECESSARY, TO COMPLETE WELL RECORD.																					
Date Received	<div style="text-align: center;">  Signature President Title 2-14-78 Date </div>																				