


Section 10 Township 4 Range 21 W

Well No. # 1 Lowery

Company Murphin & Vernon Oil

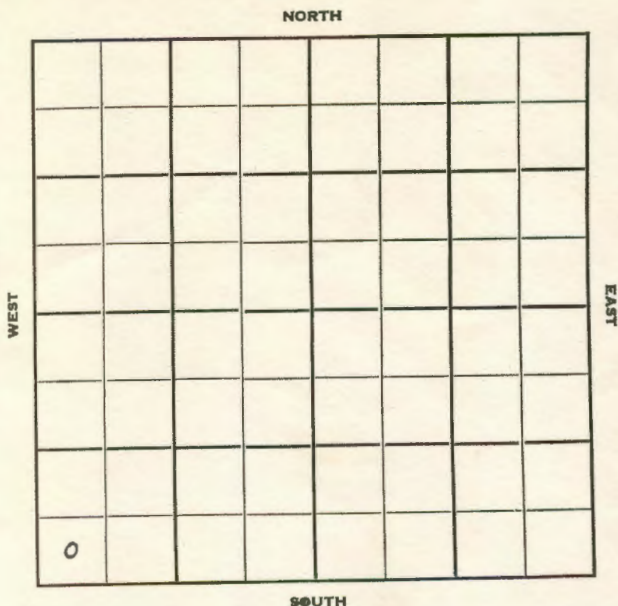

13

Sec. 10 Twp. 4 R. 21W

Well No. #1 Lawery Farm

Murphin & Vernon Oil Company

Strain -Contr. Contractor

Wildcat


Ft. from N. Line

330' Ft. from S. Line

Ft. from E. Line

330' Ft. from W. Line

SW SW SW

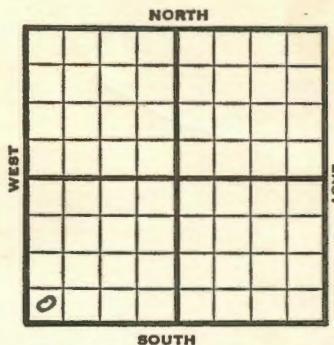

1951 **Elev. 2220'** REPORT

9/19 Pits

10/3 Spud 9-20-51

D & A TD 3788' 8" @ 215'

Anhy 1890' Top 3269' Heeb 3437'

Lans. 3474' B KC 3675' Arb. 3738'

TD 3788' D & A

ABANDONED

