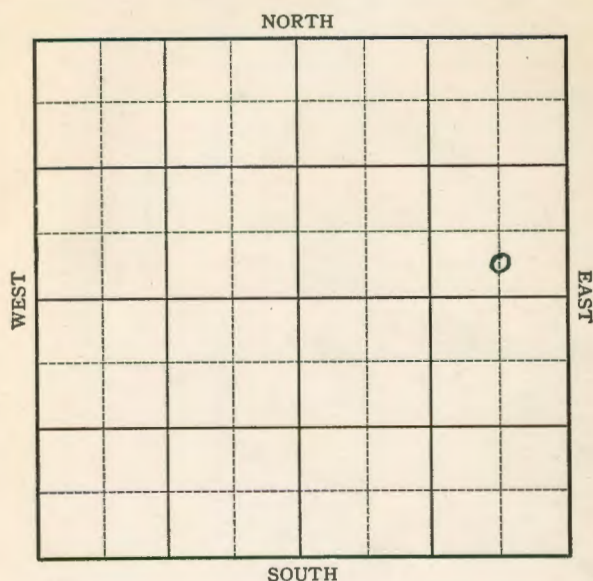


KANSAS

FORM 51 5M 4-41 PETROL

Norton

Section 11 Township 4 Range 21WWell No. 1 HewittCompany Helmerich-Payne & Phillips

8

FORM 252-A 5M 1-41 PETROL

KANSAS


Norton

Sec. 11 Twp. 4 R. 21-WWell No. #1 Hewitt FarmHelmerich-Payne & Phillips Company
(Wildcat)

Ft. from N. Line

330 Ft. from S. Line660 Ft. from E. Line

Ft. from W. Line

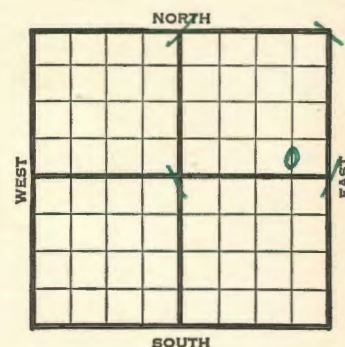Elev. 2161

1941	REPORT
6/4	Derrick.
6/12	Rigging up.
6/19	8" - 267' Any 1810'
	Drlg. 2310'
6/26	Drlg. 3239'
7/3	Lans. 3402' Arb. 3655'
	Drlg. 3707'
7/10	P.B. to 3404' 5" - 3401'
	1300' oil in 8½ hours.
	Swab 3.4 oil per hour 24 hours,
	trace water. 36.8 Gravity
7/17	1000 acid. Filled up 450' oil
	1850' water in 12 hours.
	Shut down.
7/24	PB 340' 500 acid swab 24 bbls
	oil in 2 hrs. No water.
7/31	" " " "
8/7	" " " "
8/15	Pump 10 bbls oil & 10% water
	per hour.
	OVER

1941
8/20

Lens. 3402'

P.B. to 3407'

5" - 3401'

T.D. 3750'

500 acid.

Pump 272 oil & 17 water.

36.8 Gravity

COMPLETED

Map No. 133 Sec. 11 Twp. 4 R. 21WWell No. 1 HewittHelmerich-Payne & Phillips
Company

Contractor

FIRST REPORT


C S L S E N E

Ft. from N. Line

330 Ft. from S. Line660 Ft. from E. Line

Ft. from W. Line

SECTION PLAT

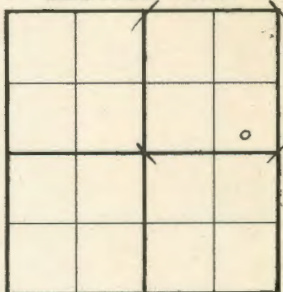

WILDCAT

Location

Rig up

Drilling and Remarks:

Derrick

RECORD

Cased in., ft.

Sand

Gas

Oil

Total Depth

PRODUCTION

1st 24 hrs. Nat.

1st 24 hrs. after shot

Gas Cu. Ft.

Dry Hole

Abandoned

Date

JUN 4 1941

S. J. LEWIS Scout

Map No. 133 Sec. 11 Twp. 4 R. 21WWell No. 1 HewittHelmerich & Payne and Phillips
Company

Contractor

COMPLETED


SECTION PLAT

C S L S E N E

Ft. from N. Line

330 Ft. from S. Line660 Ft. from E. Line

Ft. from W. Line

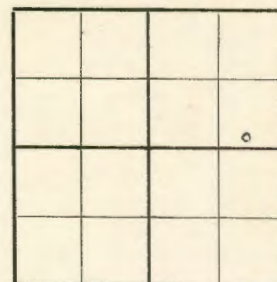

HEWITT POOL

Location

Rig up

Drilling and Remarks:

Leans 3402

PB 3402

5" C 3401

500 aciol

Pump 272 xil

17 Water 207

26 Dly.

RECORD

Cased in., ft.

Sand

Gas

Oil

Total Depth 3250

PRODUCTION

1st 24 hrs. Nat.

1st 24 hrs. after shot

Gas Cu. Ft.

Dry Hole

Abandoned

Date

AUG 20 1941

19

S. J. LEWIS

Scout