



Section 25 Township 4 Range 21-W
Well No. #1 Becker
Company H. A. Steele

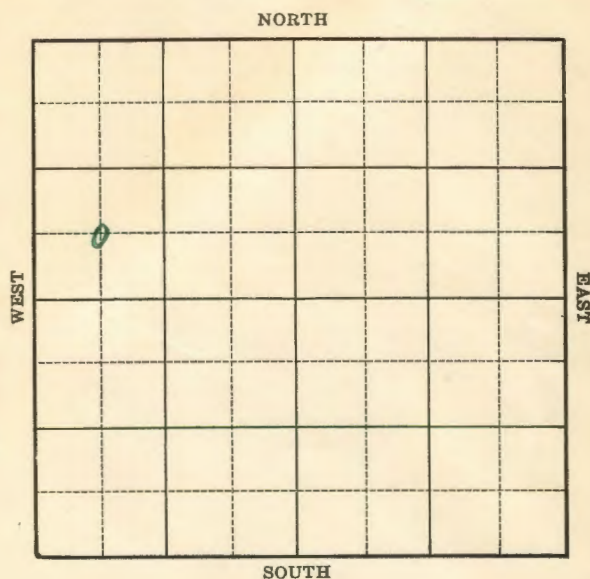

5

Sec. 25 Twp. 4 R. 21-W
Well No. #1 Becker Farm
H. A. Steele Company
Wild cat) NORTH

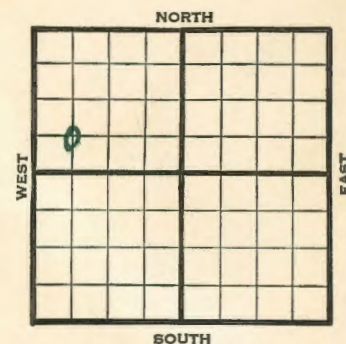

Elev. 2129

[illegible]

Map No. 133 Sec. 25 Twp. 4 R. 21WWell No. 1 BeckerH. A. Steele Company

Contractor

ABANDONED

SECTION PLAT

C SW NW

Ft. from N. Line

660 Ft. from S. Line

Ft. from E. Line

660 Ft. from W. Line

WILDCAT

Location

RECORD

Cased in., ft.

Sand

Gas

Oil

Total Depth 1234

PRODUCTION

1st 24 hrs. Nat.

1st 24 hrs. after shot

Gas Cu. Ft.

Dry Hole

Abandoned

Date

NOV 20 1940

19

S. J. LEWIS Scout

Map No. 133 Sec. 25 Twp. 4 R. 21WWell No. 1 BeckerH. A. Steele Company

Contractor

FIRST REPORT

SECTION PLAT

C SW NW

Ft. from N. Line

660 Ft. from S. Line

Ft. from E. Line

660 Ft. from W. Line

WILDCAT

Location

RECORD

Cased in., ft.

Sand

Gas

Oil

Total Depth

Rig up

Drilling and Remarks:

10" - 60'

Drlg. 520

PRODUCTION

1st 24 hrs. Nat.

1st 24 hrs. after shot

Gas Cu. Ft.

Dry Hole

Abandoned

Date

SEP 11 1940

19

S. J. LEWIS Scout