


Norton **KANSAS**

Section 30 Township 4 Range 21 W

Well No. # 1 Stone

Company N C R A

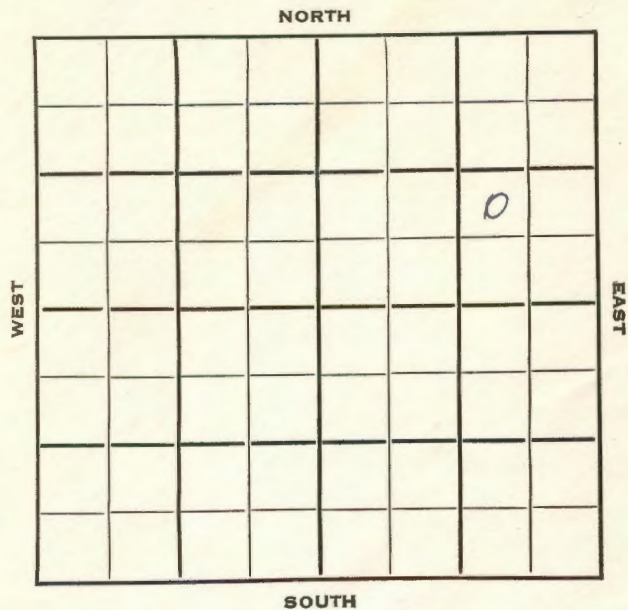

8

KANSAS

SEC.	TWP.	R.
30	4	21 W ✓

WELL NO. # 1 Stone FAR

COMPANY N C R A

CONTRACTOR Armer

Wildcat

_____ Ft. from N. Line

990 _____ Ft. from S. Line

990 _____ Ft. from E. Line

_____ Ft. from W. Line

NW SE NE

	ELEVATION	REPORT
1954	2148'	
3/24	MIRT	
3/31	8" @ 228 w/125	Anhy 1800
		Heeb 3336 Lans 3382
	DST 3334-90 2 hrs,	125' M 120' MCW
	980# Drlg. 3480	
4/7	Spud 3-22-54	
	D&A	
	TD 3688'	
	8" @ 228'	
	Anhy 1800', Heeb 3336', Lans 3382'	
	DST 3334-90', opn 2 hrs.,	rec. 125'
	mud, 120' MCW 980#	
	DST 3497-3550', opn 2 hrs.,	rec. 12'
	socm, Off	
	Arb. 3619'	
	TD 3688'	
	D&A	

ABANDONED

