


Section 35 Township 4 Range 21W

Well No. #1 Wiltraut

Company Hinkle Oil

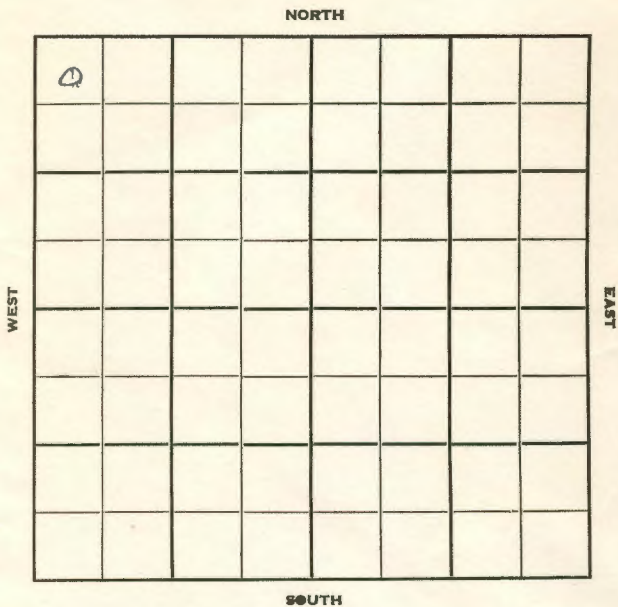

4

Sec. 35 Twp. 4 R. 21 W

Well No. #1 Wiltraut Farm

Hinkle Oil Company

Contractor


Wildcat
330 Ft. from N. Line

_____ Ft. from S. Line

_____ Ft. from E. Line

330 Ft. from W. Line

NW NW NW

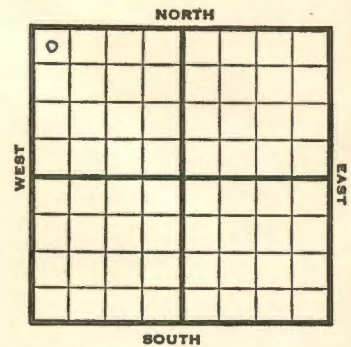

1951 **Elev. 2068'** REPORT

10/10 Spud 10-6-51
Drilling

10/24 Spud 10-6-51
D&A TD 3627'
8" @ 221'

Anhy 1690 Heeb. 3260

DST 3443-75 rec. 550' mud

Lans. 3287

DST 3287-3300 open 1 hr. rec. 270'

SW

Marm. 3500 Arb. 3563'

TD 3627'

D&A

ABANDONED

County Norton State Kansas
 Sec. 35 (Blk. 4 (Sur. 21W Map No.
 Operator Hinkle Oil
 Well No. 1 Farm Wiltraut
 Elev. 2068 Location NW NW NW

0					

330 Ft. From N Line NW
330 Ft. From W Line Quarter
 Ist. Report _____
 Completion OCT 24 1951
 Remarks Wildcat
 Spudding Date 10-6-51

Drig. Data D & A TD 3627
8" @ 221 Anhy 1690 Heeb. 3260
DST 3443-75 Rec. 550' mud Lans. 3287
DST 3287-3300 open 1 hr. Rec. 270' sw
Marm. 3500 Arb. 3563 TD 3627
D & A

J. E. TYRA

County Horton State Kansas
 Sec. 35 (Blk. 4 (Sur. 21W Map No.
 Operator Hinkle Oil
 Well No. 1 Farm Wiltraut
 Elev. _____ Location NW NW NW

0					

330 Ft. From N Line NW
330 Ft. From W Line Quarter
 Ist. Report OCT 10 1951
 Completion _____
 Remarks _____
 Spudding Date 10-6-51

Drig. Data Wildcat
Drig.

J. E. TYRA