


Section 19 Township 4 Range 21 W

Well No. # 1 Stone

Company B & R Drilling Co et al

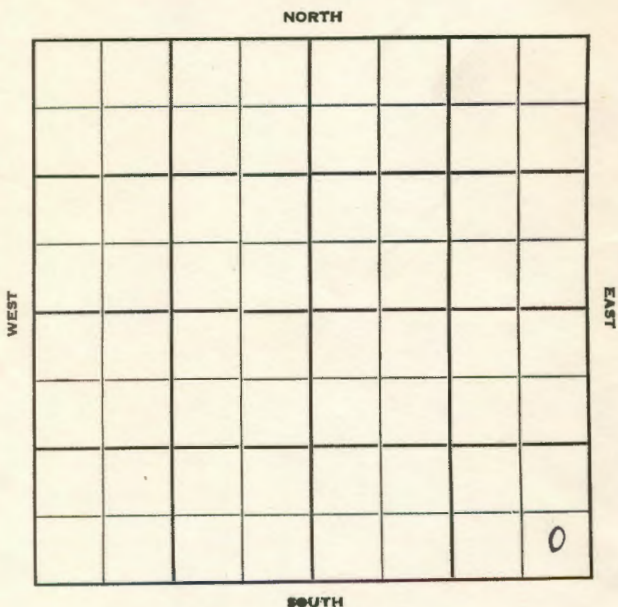

16

Sec. 19 Twp. 4 R. 21 W ✓

Well No. # 1 Stone Farm

B & R Drlg. Co. et al Company

B & R Drlg. Contractor


Wildcat

\_\_\_\_\_ Ft. from N. Line

330 Ft. from S. Line

330 Ft. from E. Line

\_\_\_\_\_ Ft. from W. Line

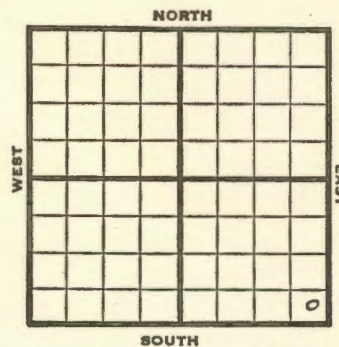

SE SE SE

Sun-Stano.-CRA (DHM)

1951 **Elev. 2176'** REPORT

6/27 Spud 6-24-51  
8" @ 209'  
Drlg. 570'

7/11 Spud 6-24-51  
D&A TD 3700  
8" @ 209'  
**Heeb. 3366 KC 3404**  
**Arb. 3661**  
TD 3700  
D&A

**ABANDONED**

County Norton State Kansas  
Sec. 19 (Blk. 4) (Sur. 21W) Map No.  
Operator B & R Drlg.  
Well No. 1 Farm Stone  
Elev. 2176 Location SE SE SE


330 Ft. From S Line SE  
330 Ft. From E Line Quarter  
1st. Report  
Completion JUL 11 1951  
Remarks Wildcat  
B & R Drlg. - Contr.  
Spudding Date 6-24-51

Drlg. Data D & A TD 3700  
8" @ 209 Heeb. 3366 KC 3404  
Arb. 3661 TD 3700  
D & A

J. E. TYRA

County Norton State Kansas  
Sec. 19 (Blk. 4) (Sur. 21W) Map No.  
Operator B & R Drilling Co - etal  
Well No. 1 Farm Stone  
Elev. Location SE SE SE


330 Ft. From S Line SE  
330 Ft. From E Line Quarter  
1st. Report JUN 27 1951  
Completion  
Remarks Sun-Stano.-CRA-(DHW)  
B & R Drlg. - Contractor  
Spudding Date 6-24-51

Drlg. Data Wildcat  
8" @ 209 Drgl. 570

J. E. TYRA