


Section 11 Township 4 Range 22W

Well No. #1 Fisher

Company Jones, Shelburne & Farmer

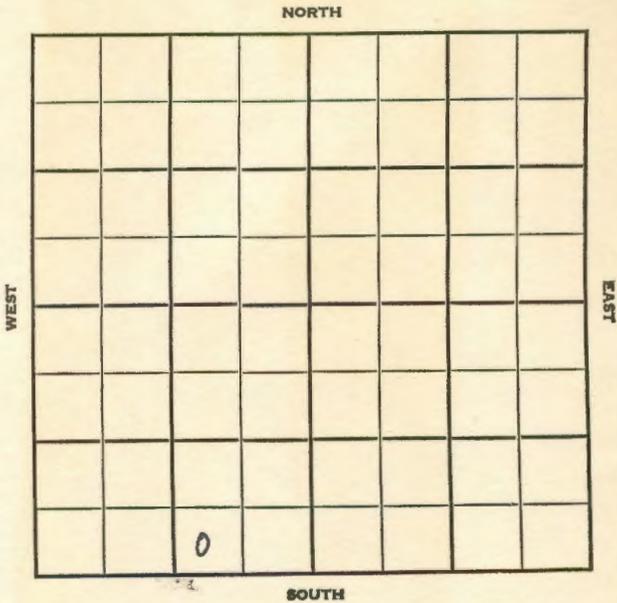

14

SEC.	TWP.	R.
11	4	22 W

WELL NO. # 1 Fisher FARM

COMPANY Jones, Shelburne & Farmer

CONTRACTOR J-S-F

Wildcat


_____ Ft. from N. Line

330 _____ Ft. from S. Line

990 _____ Ft. from E. Line

_____ Ft. from W. Line

SW SE SW

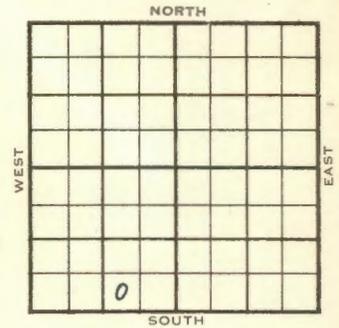

	ELEVATION	REPORT
1954	2236'	

5/19 Spud 5-12-54
 8" @ 280 **Anhy 1903'**
 Drlg. 2775'

5/26 Spud 5-12-54
 D&A
 TD 3767'
 8" @ 280'
**Anhy 1903', Heeb 3428', Lans 3475',
 B KC 3668', Cong 3730', Arb. 3757'**
 TD 3767'
 D&A

ABANDONED

