


Section 16 Township 4 Range 22W

Well No. #1 Wilds

Company Jones, Shelburne & Farmer

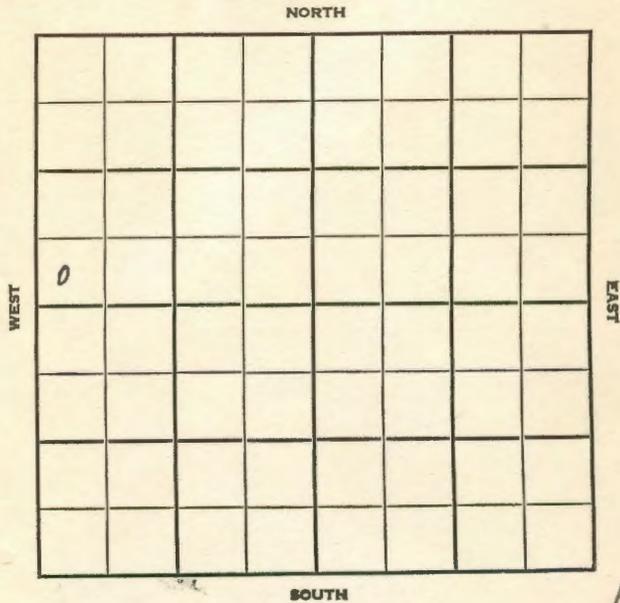

Norton KANSAS

SEC. 16 TWP. 4 R. 22 W ✓

WELL NO. #1 Wilds FARM

COMPANY Jones, Shelburne & Farmer

CONTRACTOR J-S-F

Wildcat

_____ Ft. from N. Line

330 _____ Ft. from S. Line

_____ Ft. from E. Line

330 _____ Ft. from W. Line

SW SW NW

	ELEVATION	REPORT
1954	2363'	
5/19	Location	
6/2	Spud 5-22-54	
	D&A	
	TD 3892'	
	8" @ 280'	
	Anhy 2017', Heeb 3520', Tor 3547',	
	Lans 3566'	
	DST 3584-3611', opn 1 hr., rec. 290'	
	SW, 1240#	
	Gorham 3830', Arb. 3843', Reagan 3854'	
	Gr Wash 3880', Gr 3885'	
	TD 3892'	
	D&A	
		ABANDONED

