


Norton KANSAS

Section 19 Township 4 Range 22 W
Well No. # 1 Wiley
Company Jones, Shelburne & Farmer

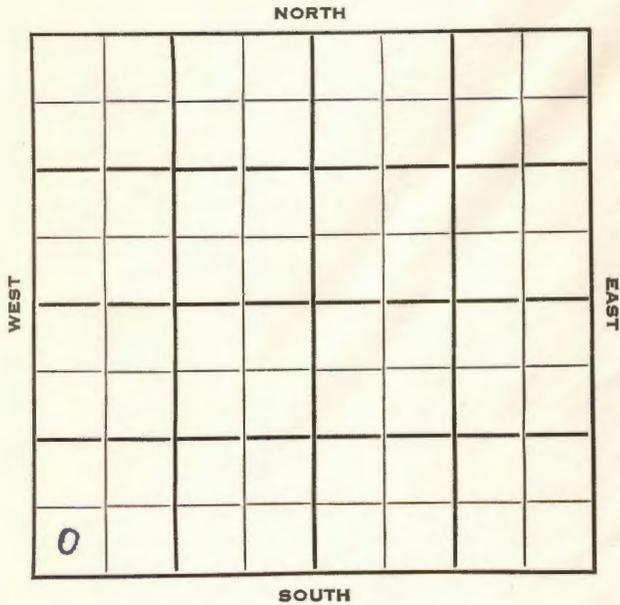

13


Norton KANSAS

SEC. 19 TWP. 4 R. 22W ✓

WELL NO. #1 Wiley FARM

COMPANY Jones, Shelburne & Farmer

CONTRACTOR

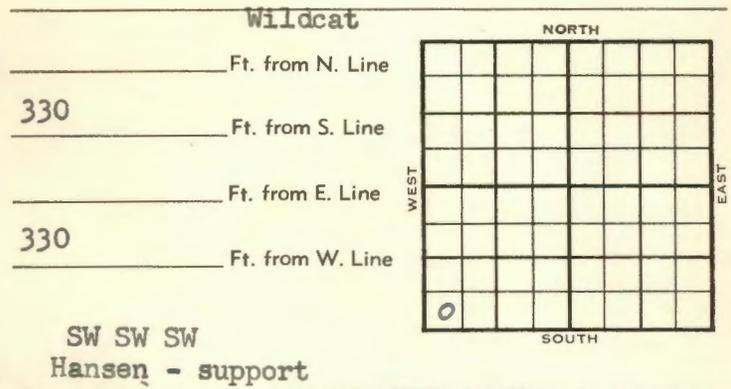

	ELEVATION	REPORT
1953	2253'	
10/14	Location	
10/21	"	
10/28	8" @ 238 Drlg. 1840'	
11/4	Heeb 3369' Tor 3395' Lans 3410' DST 3464-90, 1/2 hr, 3' M DST 3673-78, 1 hr, 1400' SW	
11/11	Spud 10-26-53 D & A TD 3720' 8" @ 238' Heeb 3369', Tor 3395', Lans 3410' DST 3464'-90' opn 1/2 hr, rec 3' mud Off DST 3673'-78' opn 1 hr, rec 1400' sw Granite 3714' TD 3720' D & A	

ABANDONED

