


Section 36 Township 4 Range 22W

Well No. #1 Walters

Company Harry Gore

NORTH

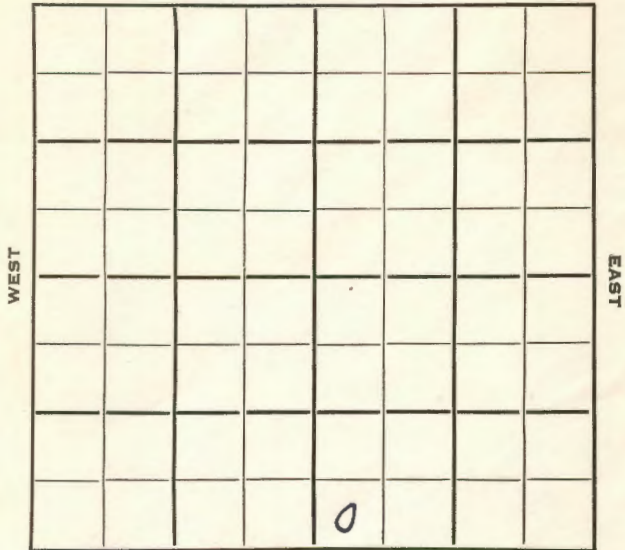

SOUTH

15

Sec. 36 Twp. 4 R. 22W

Well No. #1 Walters Farm

Harry Gore Company

Empire Drlg. Wildcat Contractor

Ft. from N. Line


330 Ft. from S. Line

Ft. from E. Line

330 Ft. from W. Line

SW SW SE
Sun - DHM

NORTH

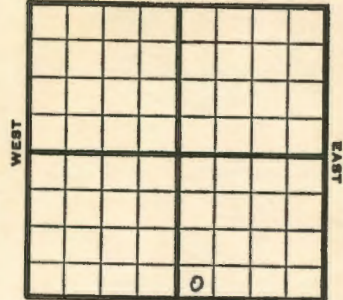

SOUTH

1953 **Elev. 2180'** REPORT

7/8 Spud 7-2-53
8" @ 196
Drlg. 2970'

7/15 Spud 7-2-53
D & A TD 3710' 8" @ 196
Top 3178 Heeb 3330'
Tor. 3354 Lans 3374 B KC 3563
Cong. 3619 Arb 3650 Regan 3670
Granite 3702 TD 3710
D & A

ABANDONED

