


SECTION 1 TOWNSHIP 4 RANGE 23 W
WELL NO. #1 Rice
COMPANY Walters Drlg. & Sunray Mid-Continent

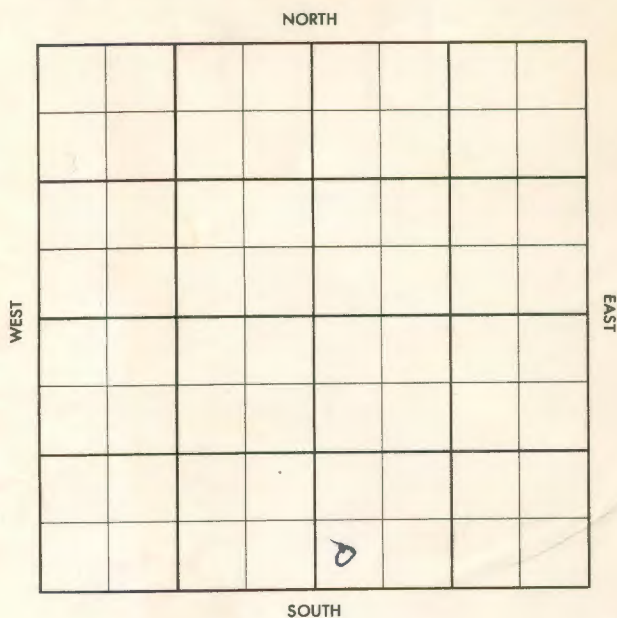


15

SEC.		TWP.	R.
1		4 S	23 W
WELL NO.			
#1 Rife			FARM
COMPANY			
CONTRACTOR			

Walters Drlg.
Wildcat

_____ Ft. from N. Line
_____ Ft. from S. Line
_____ Ft. from E. Line
_____ Ft. from W. Line

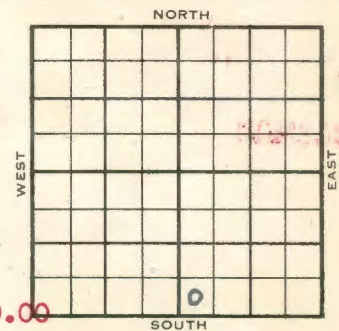

SW SW SE
SDX - To receive \$1,250.00
from Harry Gore.
Sohio - DHM

1955	ELEVATION 2300' KB	REPORT (WH5-BH24)
------	-----------------------	----------------------

10/26	Basal Sand test well - @3750'		
	To be commenced by Nov. 7, 1955		
	To be completed by Dec. 7, 1955		
	(See Lse. Pur. Agreement Ltr. 10-25-5)		
11/1	Moving in rotary tools.	(Card-Walters)	
11/2	MIR	(F.R.Tkt)	
11/2	Spud 11-1-55		
	8-5/8" @ 206 w/125 sks.		
	WOC	(Card-Walters)	
11/3	Drlg. 1238'	"	
11/4	Drlg. 2195'.	Anhydrite 1900'	"
11/7	Drlg. 3110'		"
11/8	Drlg. 3338'		"
11/9	Drlg. 3509'		"
11/10	Drlg. 3636'.		
	Heebner 3394',	Toronto 3414',	
	Lans. KC 3434',	Base KC.	
	No shows in Lansing KC.		"
11/11	DST 3666-3676, open 1 hr, weak steady blow, rec 90' muddy wtr, sli oil cut, 15 min BHP 580#.		

DX-78

OVER

1955
11/11

(Information continued)

Tops: Basal Sand 3672', Granitex
Wash 3676', Fresh Granite 3726'
TD 3732'

Ran elec log & micro log.

Tops & measurements check O.K.

Getting ready to plug & Abandon.

D & A. (Card-Walters ϕ)

11/22

Received copy of Elec. Log

& Micro-Log from Walters Drlg.

Advised Contract Section-D & A

11/15

11/16

Comm. 11-1-55

8-5/8" @ 206/125

DST 3666-76 open 1 hr rec 90' SOCMW

580/15" D & A. TD 3733'

Anh. 1900', H. 3394', Tr. 3414',

KC 3434', BKC 3626', Basal sd 3672'

G. Wash 3676', Granite 3726'

TD 3733' D & A

ABANDONED

County Norton Elev. 2298
 Sec. 1 Twp. 4 Rge. 23W
 Company Walters Drlg. & Sunray Mid-Continent
 Farm Name Rife No. 1

TOPS	DEPTH	LOG	DATUM	Loc. in Sec.
Anb.	1900			SW SW SE
TP.				
H.	3394		1096	
Tr.	3414		1116	
Dg.				
BL.				
L.				
K.C.	3434		1136	Geol.
B.K.C.	3626		1328	Contr.
Ce. <u>Basal ad</u>	3672		1374	Walters Drlg.
C.				Pool
M.				Wildcat
M.				
K.				
Mz.				
Me.				
V.				
S.				
S.				
A.				
R.				
PE.				
G.	3676		1378	
G.	3726		1428	
TD.	3733			

Date Comm. 11-1-55 NOV 1 6 1955
 8 5/8" @ 206/125 DST 3666-76 open

1 hr. rec. 90' socm 580/15"

D & A

County Norton Elev. 23W
 Sec. 1 Twp. 4 Rge. 23W
 Company Walters Drlg. & Sunray Mid-Continent
 Farm Name Rife No. 1

TOPS	DEPTH	LOG	DATUM	Loc. in Sec.
Anb.				SW SW SE
TP.				
H.				
Tr.				
Dg.				
BL.				
L.				Geol.
K.C.				Contr.
B.K.C.				Walters Drlg.
Ce.				Pool
C.				Wildcat
M.				
M.				
K.				
Mz.				
Me.				
V.				
S.				
S.				
A.				
R.				
PE.				
G.				
TD.				

Date Comm. SOBIO DIM
M I R

NOV 2 55
 FIRST REPORT