


**KANSAS**

Norton

Section 3 Township 4 Range 23WWell No. #1 ComstockCompany Tom Allan & Aylward

NORTH

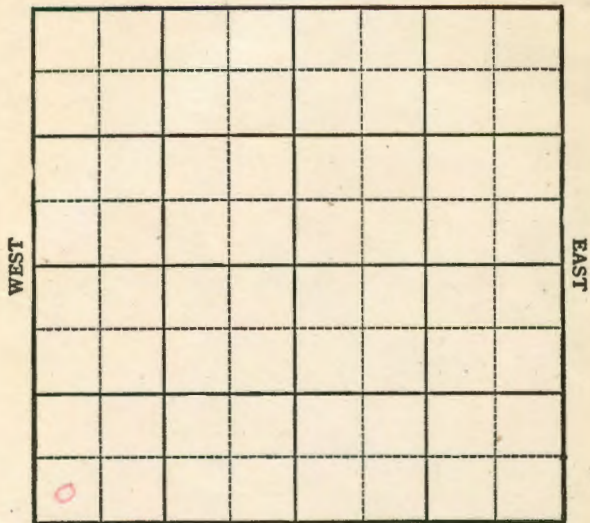

SOUTH

13

**KANSAS**

Norton County

Sec. 3 Twp. 4 R. 23WWell No. #1 Comstock FarmTom Allan & Aylward Company

Wildcat

\_\_\_\_\_ Ft. from N. Line


330 Ft. from S. Line

\_\_\_\_\_ Ft. from E. Line

330 Ft. from W. Line

SW/C

NORTH

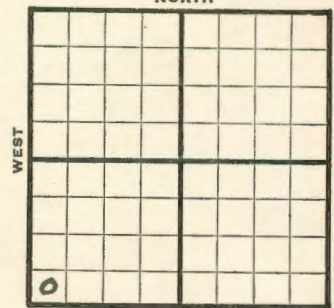

SOUTH

1944

REPORT

8/9 Cellar  
 8/16 "  
 8/23 8" @ 396  
 Anhy 2084  
 Drlg. 2734  
 8/30 Lans 3582 SS0 3659-63  
 3770 fag.  
 9/6 Arb 3842  
 Weathered Quartzite 3871  
 TD 3900'


**ABANDONED**

**KANSAS** Pool Name Wildcat  
Map No. 134 Sec. 3 Twp. 4 R. 23W  
Well No. 1 Comstock  
Tom Allan & Aylward Company  
ABANDONED Contractor

SW/C

SECTION PLAT

Ft. from N. Line  
330 Ft. from S. Line  
Ft. from E. Line  
330 Ft. from W. Line

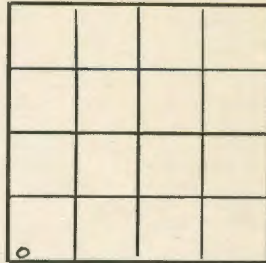

Norton County

Location \_\_\_\_\_

Rig up \_\_\_\_\_

Drilling and Remarks:

*Cell 8 3842*  
*Wear Thersol L. catalyst*  
*3871*

**RECORD**  
Cased \_\_\_\_\_ in., \_\_\_\_\_ ft.  
Sand \_\_\_\_\_

Gas \_\_\_\_\_  
Oil \_\_\_\_\_  
Total Depth 3944

**PRODUCTION**

1st 24 hrs. Nat. \_\_\_\_\_  
1st 24 hrs. after shot \_\_\_\_\_  
Gas \_\_\_\_\_ Cu. Ft.  
Dry Hole \_\_\_\_\_  
Abandoned \_\_\_\_\_

Date


SEP 6 1944 19 S. J. LEWIS Scout

**KANSAS** Pool Name Wildcat  
Map No. 134 Sec. 3 Twp. 4 R. 23W  
Well No. 1 Comstock  
Tom Allan & Aylward Company  
FIRST REPORT Contractor

SW/C

SECTION PLAT

Ft. from N. Line  
330 Ft. from S. Line  
Ft. from E. Line  
330 Ft. from W. Line

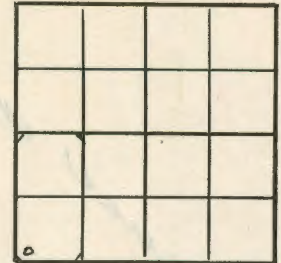

Norton County

Location \_\_\_\_\_

Rig up \_\_\_\_\_

Drilling and Remarks:

Cellar

**RECORD**  
Cased \_\_\_\_\_ in., \_\_\_\_\_ ft.  
Sand \_\_\_\_\_

Gas \_\_\_\_\_  
Oil \_\_\_\_\_  
Total Depth \_\_\_\_\_

**PRODUCTION**

1st 24 hrs. Nat. \_\_\_\_\_  
1st 24 hrs. after shot \_\_\_\_\_  
Gas \_\_\_\_\_ Cu. Ft.  
Dry Hole \_\_\_\_\_  
Abandoned \_\_\_\_\_

Date

AUG 9 1944 19 S. J. LEWIS Scout