


Section 1 Township 4 Range 24W

Well No. 5 Green

Company Nate Appleman

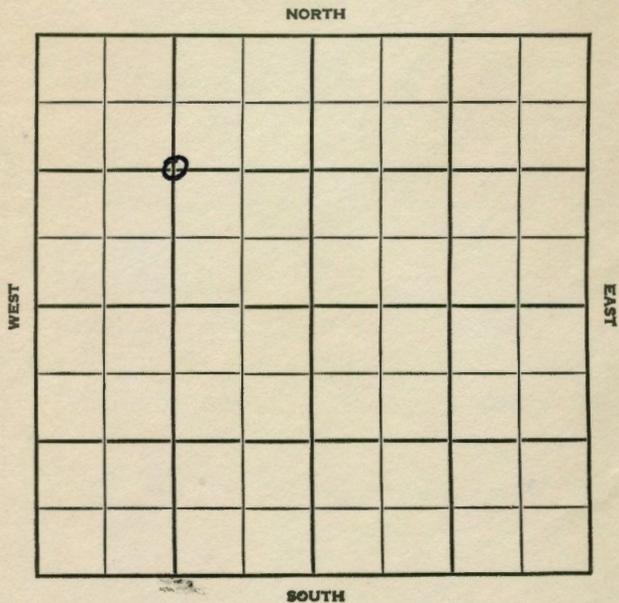

3

Norton KANSAS

SEC. 1 TWP. 4 R. 24W
 WELL NO. _____
 COMPANY 5 Green FARM _____
 CONTRACTOR Nate Appleman

J-S-F


Norton Pool

1320 Ft. from N. Line

_____ Ft. from S. Line

_____ Ft. from E. Line

1320 Ft. from W. Line

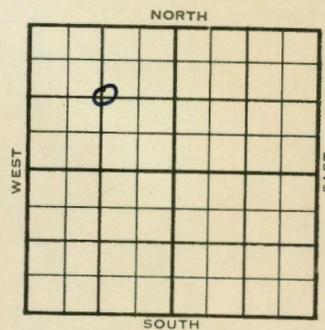

C NW/4

	ELEVATION	REPORT
1954	2504 - 2498'	LS

8/4 Spdg 7-22-54
 8" @ 280
 Anhy 2082 Heeb. 3527 Tor. 3552
 KC 3567 BKC 3757 Arb. 3827
 TD 3830
 5" @ 3828

8/18 Spud 7-22-54
 D&A
 TD 3830½'
 8" @ 280'
 Anhy 2082', Heeb 3527', Tar 3552',
 KC 3567', B KC 3757', Arb. 3827'
 TD 3830'
 5" @ 3828'
 DD 3830½', 1000A 9 bwph
 D&A

ABANDONED

