


Section 2 Township 4 Range 24W

Well No. #4 Henry

Company Harry Gore

NORTH

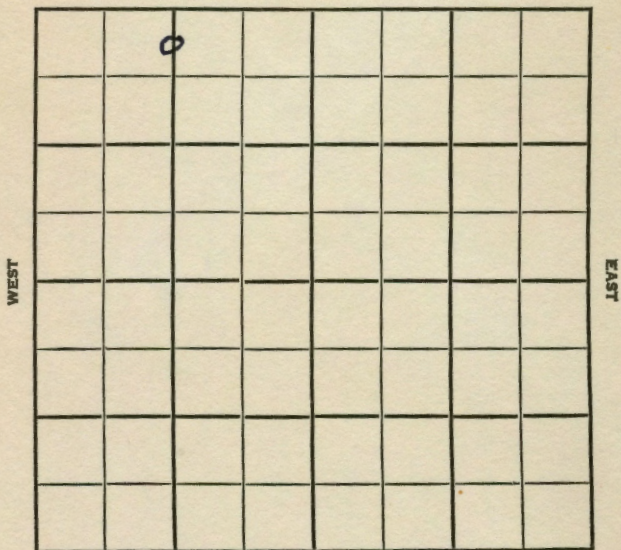

SOUTH

3

SEC. <u>2</u>	TWP. <u>4</u>	R. <u>24W</u>
---------------	---------------	---------------

WELL NO. 4 Henry

COMPANY Harry Gore FARM

CONTRACTOR Empire Drlg. Norton Pool


330 Ft. from N. Line

_____ Ft. from S. Line

_____ Ft. from E. Line

1320 Ft. from W. Line

NORTH

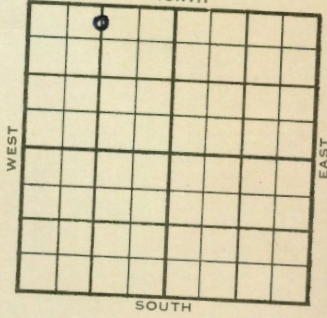

SOUTH

C N/2 N/2 NW

1955

ELEVATION

REPORT

4/6

Spud 3-31-55
 8" @ 313'
 rlg. 3100'

