


Section 2 Township 4 Range 24W

Well No. 2 Shoen "B"

Company Jones, Shelburne & Farmer

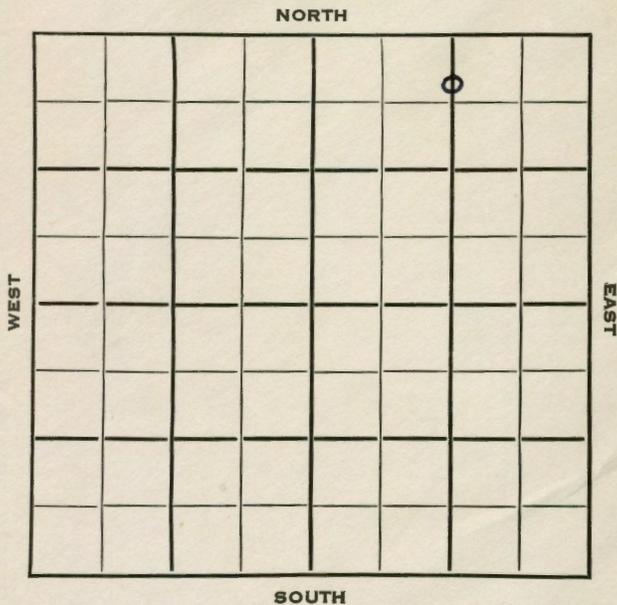

Norton KANSAS

SEC. 2 TWP. 4 R. 24 W

WELL NO. 2

COMPANY # 2 Shoen "B" FARM

CONTRACTOR Jones, Shelburne & Farmer

J-S-F

440 Norton Pool

\_\_\_\_\_ Ft. from N. Line

\_\_\_\_\_ Ft. from S. Line

1320 \_\_\_\_\_ Ft. from E. Line

\_\_\_\_\_ Ft. from W. Line

C N $\frac{1}{2}$  N $\frac{1}{2}$  NE

	ELEVATION	REPORT
1954	2477'	
1/13	RUR	
1/20	8" @ 280' w/125 sks	Anhy 2054', Heeb 3500', Tor 3529', Lans 3543', B KC 3729', Arb. 3791'
	RTD 3797'	
	5" @ 3793'	
1/27	NR	
2/3	CO 3797'	S/20 BOPH 3 hrs.
2/10	NR	
3/3	Spud 1-12-54	
	Oil Well	
	TD 3797'	
	8" @ 280'	
	Anhy 2054', Heeb 3500', Tor 3529',	
	Lans 3543', B KC 3729', Arb. 3791'	
	TD 3797'	
	5" @ 3793'	
	CO to 3797'	
	S/20 boph 3 hrs.	
	Comp. 240 bopd	

**COMPLETED**

