


Section 2 Township 4 Range 24W

Well No. 4 Schoen "B"

Company Jones Shelburne & Farmer

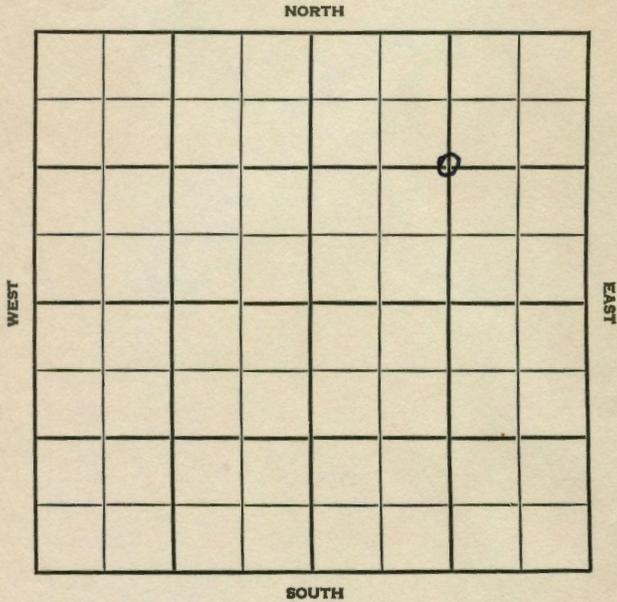

SOUTH

SEC. 2 TWP. 4 R. 24W

WELL NO. 4 Schoen "B" COMPANY FARM

CONTRACTOR Jones Shelburne & Farmer


J&F
Norton Poole

1320 Ft. from N. Line

_____ Ft. from S. Line

1320 Ft. from E. Line

_____ Ft. from W. Line

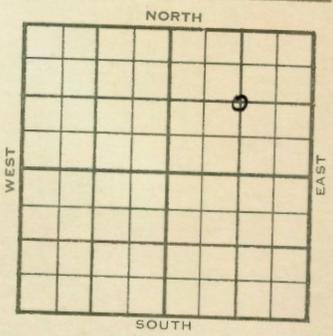

C NE/4

	ELEVATION	REPORT
1954	2475'	

6/8 8" @ 278
 Any 2051
 Drlg. 2905

6/30 CO 3799' 7 1/2 boph

7/7 NR

7/14 Spud 6-4-54 Oil well TD 3799
 8" @ 278 Any 2051 Heeb 3497
 Tor. 3526 Lans 3541 B KC 3722
 Arb. 3795 TD 3799 5" @ 3796
 CO to 3799 7 1/2 BOPH
 Comp. 212 BOPD

COMPLETED

County **Norton** State **Kansas**
 Sec. **2** (Blk. **4** (Sur. **24W** Map No.
 Operator **Jones, Shelburne & Farmer**
 Well No. **4** Farm **Schoen "B"**
 Elev. **2475** Location **C NE/4**




1320 Ft. From **N** Line **NE**
1320 Ft. From **E** Line **Quarter**
 Ist. Report
 Completion **JUL 14 1954**
 Remarks **Norton Pool**
J-S-F - Contr.
 Spudding Date **6-4-54**

Drlg. Data **Oil well TD 3799**
8" @ 278 Anhy 2051 Heeb. 3497
Tor. 3526 Lans. 3541 B KC 3722
Arb. 3795 TD 3799 5" @ 3796
CO to 3799 7 1/2 boph Comp. 212 bopd

J. G. McGEHEE

County **Norton** State **Kansas**
 Sec. **2** (Blk. **4** (Sur. **24W** Map No.
 Operator **Jones, Shelburne & Farmer**
 Well No. **4** Farm **Schoen "B"**
 Elev. Location **C NE/4**

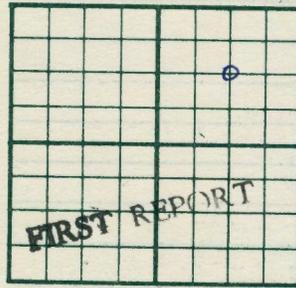

1320 Ft. From **N** Line **NE**
1320 Ft. From **E** Line **Quarter**
 Ist. Report **JUN 9 1954**
 Completion
 Remarks
J-S-F - Contr.
 Spudding Date **6-4-54**

Drlg. Data **Norton Pool**
8" @ 278 Anhy 2051 drlg. 2905

J. G. McGEHEE