


Section 2 Township 4 Range 24W

Well No. 5 Schoen "B"

Company Jones, Shelburne & Farmer

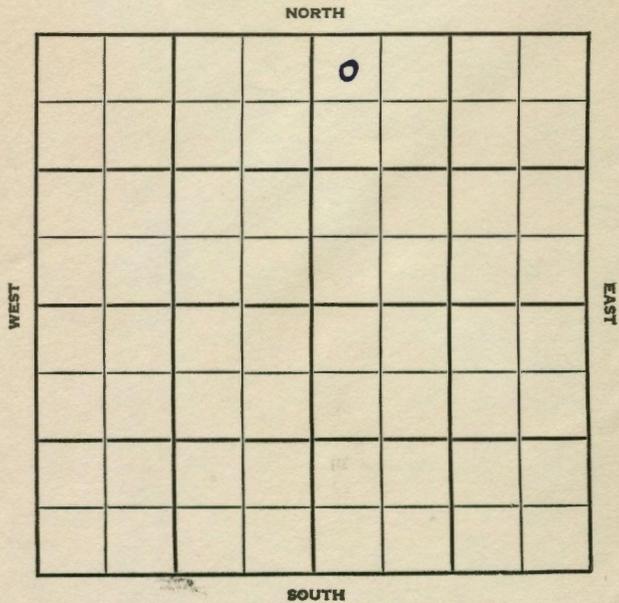

SEC. <u>2</u>	TWP. <u>4</u>	R. <u>24W</u>
---------------	---------------	---------------

WELL NO. 5 Schoen "B" FARM

COMPANY Jones, Shelburne & Farmer


CONTRACTOR J-S-F Norton Pool

330 Ft. from N. Line

_____ Ft. from S. Line

_____ Ft. from E. Line

330 Ft. from W. Line

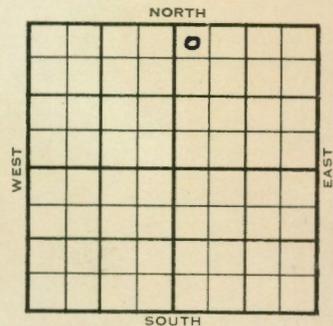

NW NW NE

1954	ELEVATION <u>2427'</u>	REPORT
------	------------------------	--------

8/4 Spdg 8-1-54
 8" @ 285
 Drlg. 550

9/15 Spud 8-1-54 Oil well TD 3746
 8" @ 285 Anhy 2002 Heeb 3447
 KC 3488 B KC 3674 Arb. 3742
 TD 3746 5" @ 3743 OO to 3746
 S/7 1/2 BOPH Comp. 180 BOPD

COMPLETED

