


Norton


DX 78-1

KANSAS

Section 2 Township 4 Range 24W  
 Well No. #6 Schoen "B"  
 Company Jones, Shelburne & Farmer

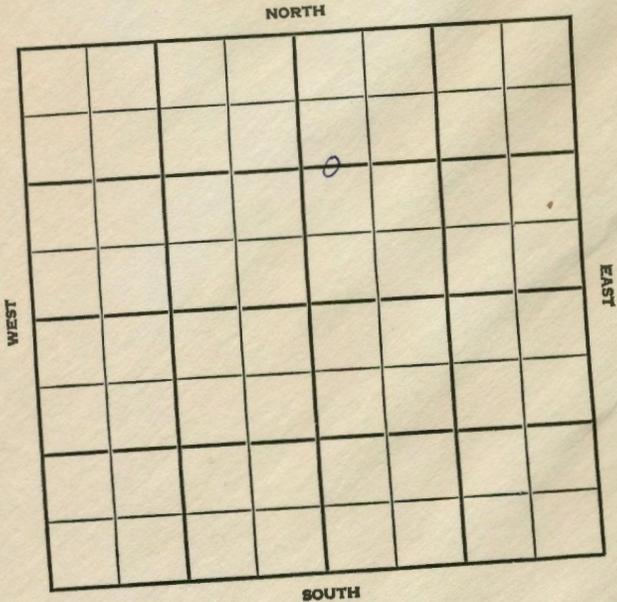

SEC.	2	TWP.	4	R.	24W
WELL NO.	6 Schoen "B"				
COMPANY	Jones, Shelburne & Farmer				
CONTRACTOR	Co. tools Norton Pool				
1320	Ft. from N. Line				
	Ft. from S. Line				
	Ft. from E. Line				
440	Ft. from W. Line				
C $W\frac{1}{2}$ $W\frac{1}{2}$ NE					

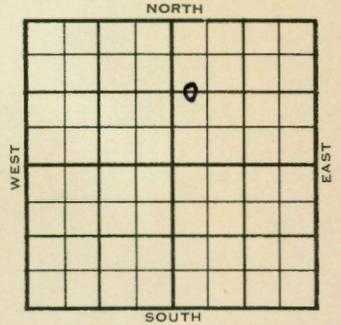

1954	ELEVATION	REPORT
	2438	
8-25	Spdg 8-20-54 8" @ 280 Anhy 2012 Drlg. 2830	
10/6	Spud 8-20-54 - Oil Well TD 3759' 8" @ 280' Anhy 2012', Heeb 3458', Mans 3498', B KC 3683', Arb. 3754' TD 3757' 5" @ 3754' DD 3759' S/3 boph 500A S/10 boph 13% wtr. 5 hrs. Comp. 100 bopd 40% wtr.	
<b>COMPLETED</b>		

2

