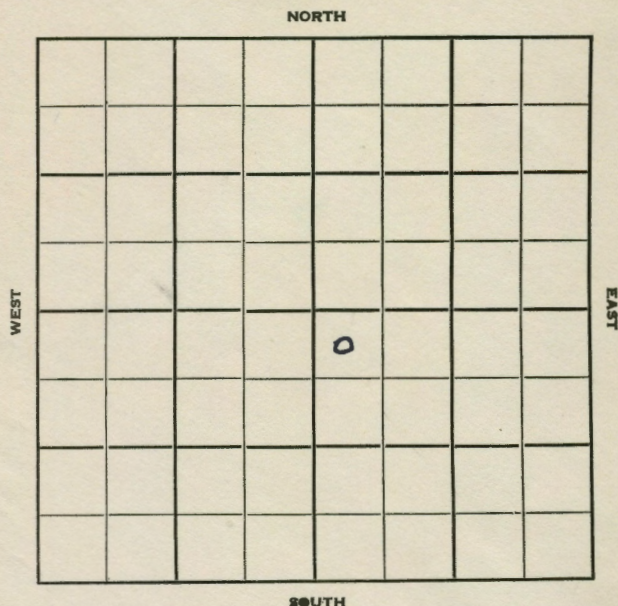


Section 36 Township 4 Range 25WWell No. #1 ZeirlinCompany Anschutz

/0

Sec. 36 Twp. 4 R. 25 WWell No. # 1 Zeirlin

Farm

Anschutz

Company

Anschutz

Contractor

Wildcat330 Ft. from N. Line


Ft. from S. Line

Ft. from E. Line

330 Ft. from W. Line

NW NW SE

Atlantic support

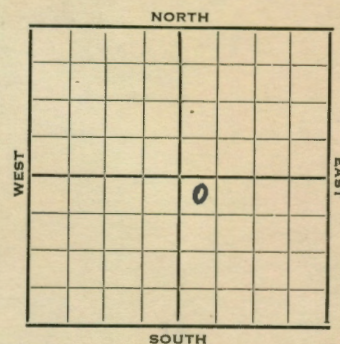

1952

Elev. -2403 REPORT

7/2

Spud 6-28-52

8" @ 230'

Drlg. 2350'

7/9

Spud 6-28-52

D & A TD 3918' 8" @ 230'

Heeb 3479' Tor. 3499' Lans. 3516'

DST 3597-3620 open $\frac{1}{2}$ hr. rec 15' mud

Cong. 3852' Arb. 3868'

TD 3918' D & A

ABANDONED

3868
2403
-1465

County Norton State Kansas
 Sec. 36 (Blk. 4 (Sur. 25W Map No.
 Operator Anschutz Drlg.
 Well No. 1 Farm Zeirlin
 Elev. Location NW NW SE



330 Ft. From N Line SE
330 Ft. From W Line Quarter
 Ist. Report
 Completion JUL 9 1952
 Remarks Wildcat
Anschutz Drlg. - Contr.
 Spudding Date 6-28-52


Drlg. Data D & A TD 3918

8" @ 230 Heeb. 3479 Tor. 3499
Lans. 3516 DST 3597-3620 open $\frac{1}{2}$ hr.
Rec. 15' mud Cong. 3852 Arb. 3868
TD 3918

D & A

J. G. McGEHEE

County Norton State Kansas
 Sec. 36 (Blk. 4 (Sur. 25W Map No.
 Operator Anschutz
 Well No. 1 Farm Zeirlin
 Elev. Location NW NW SE

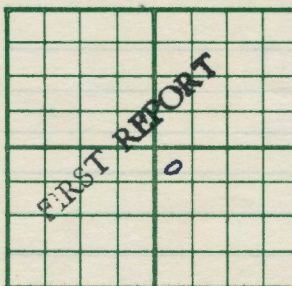

330 Ft. From N Line SE
330 Ft. From W Line Quarter
 Ist. Report JUL 2 1952
 Completion
 Remarks Atlantic -support
Anschutz - Contr.
 Spudding Date 6-28-52

Drlg. Data Wildcat

8" @ 230 Drlg. 2350

J. G. McGEHEE