


KANSAS

Section 27 Township 4 Range 26 W

Well No. # 1 Nauer

Company H. Gore

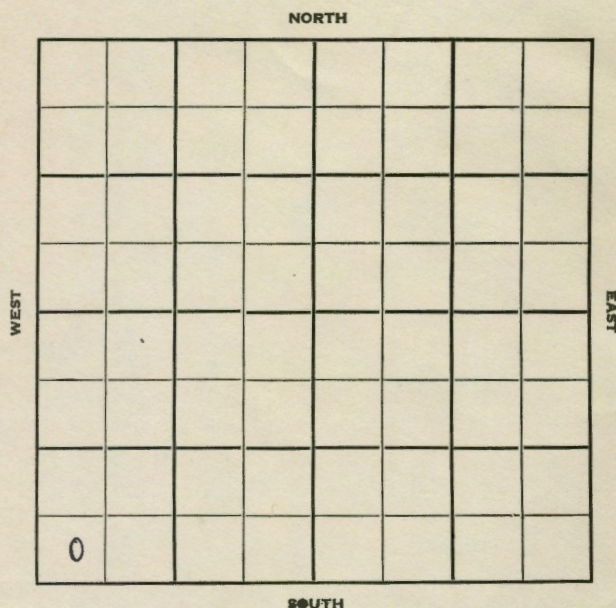

SOUTH

13

Decatur

KANSAS

Sec. 27 Twp. 4 R. 26 W

Well No. # 1 Nauer Farm

H. Gore _____ Company

Veeder _____ Contractor

Wildcat

_Ft. from N. Line


330 _____ Ft. from S. Line

Ft. from S. Line

_Ft. from E. Line

330 Ft. from W. Line

SW SW SW
MCPC NW/4

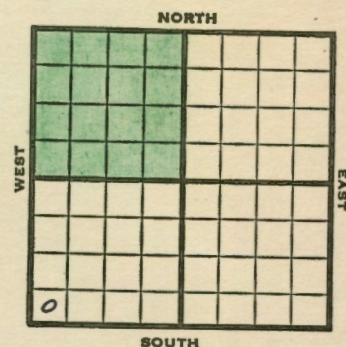

SOUTH

1951 | Elev. 2602' | REPORT

7/11	R U R
------	-------

7/19	8" at 503' Drilling 2695'.
------	-------------------------------

(L R)

7/26
Anhy. 2194'
Topeka 3410'
Heebner 3591'
Lansing 3636'
DST. 3651'-60' - open 20 minutes
Rec. 25' mud
800#
B KC 3827'
Arb. 4011'
TD. 4055' D & A.

D & A.

ABANDONED


$$\begin{array}{r} 4011 \\ 2602 \\ \hline 1409 \end{array}$$

County **Decatur** State **Kansas**
 Sec. **27** (Bk. Twp.) **4** (Sur. Rge.) **26W** Map No.

Operator **H. Gore**

Well No. **1** Farm **Nauer**

Elev. Location **SW SW SW**

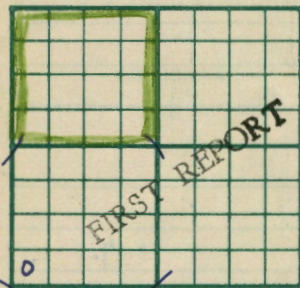

330 Ft. From **S** Line **SW**

330 Ft. From **W** Line Quarter

1st. Report **JUL 11 1951**

Completion

Remarks **(MCPC NW/4)**

Veeder-Contr.

Spudding Date

Drig. Data **Wildcat**

RUR


J. E. TYRA

County **Decatur** State **Kansas**
 Sec. **27** (Bk. Twp.) **4** (Sur. Rge.) **26W** Map No.

Operator **Harry Gore**

Well No. **1** Farm **Nauer**

Elev. **2602** Location **SW SW SW**

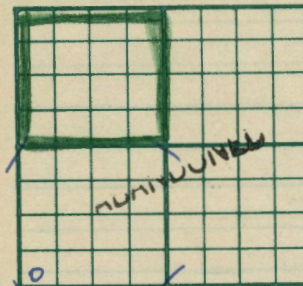

330 Ft. From **S** Line **SW**

330 Ft. From **W** Line Quarter

1st. Report

Completion **JUL 25 1951**

Remarks **Wildcat**

Veeder - Contr.

Spudding Date **7-11-51**

Drig. Data **D & A** **TD 4055**

8" @ 503 **Anhy 2194** **Top. 3410**

Heeb. 3591 **Lans. 3636** **DST 3651-60**

open 20 min. **Rec. 25' mud** **B KC 3827**

Arb. 4011 **TD 4055**

D & A

J. E. TYRA