


Section 12 Township 4 Range 26 W

Well No. #1 Norris

Company H. Gore

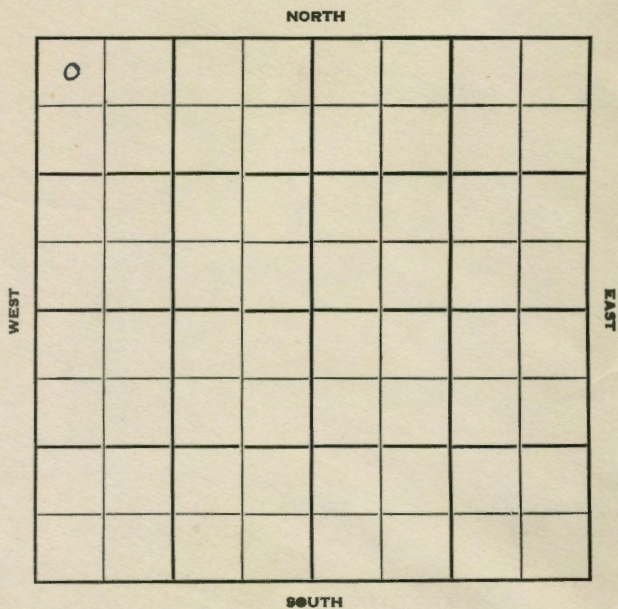

4

Sec. 12 Twp. 4 R. 26W

Well No. #1 Norris Farm

H. Gore Company


Veeder Wildcat Contractor

330' Ft. from N. Line

Ft. from S. Line

Ft. from E. Line

330' Ft. from W. Line

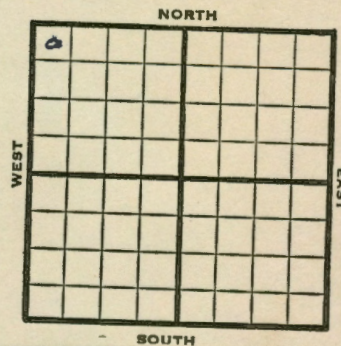

NW NW NW
Veeder-Contr.

1951 Elev. 2412' REPORT

9/12 Location
 9/26 Spud 9-13-51
 D&A TD 3920'
 8" @ 219'

Top 3222' Heeb. 3426' Lans. 3468'
 B KC 3663' Cong. 3795'
 Ch. Cong. 3808' Arb. 3865'
 TD 3920'
 D&A

ABANDONED

County Decatur State Kansas
Sec. 12 (Blk. 4 (Sur. 26W Map No.
Operator H. Gore
Well No. 1 Farm Norris
Elev. 2412 Location NW NW NW

0

330 Ft. From N Line NW
330 Ft. From W Line Quarter
1st. Report
Completion SEP 26 1951
Remarks
Veeder - Contr.
Spudding Date 9-13-51

Drig. Data D & A TD 3920
8" @ 219 Top. 3222 Heeb. 3426
Lans. 3468 B KC 3663 Cong. 3795
Ch. Cong. 3808 Arb. 3865 TD 3920
D & A

J. E. TYRA

County Decatur State Kansas
Sec. 12 (Blk. 4 (Sur. 26W Map No.
Operator H. Gore
Well No. 1 Farm Norris
Elev. Location NW NW NW

0

330 Ft. From N Line NW
330 Ft. From W Line Quarter
1st. Report SEP 12 1951
Completion
Remarks
Spudding Date

Drig. Data Wildcat
Location

J. E. TYRA