



Section 4 Township 4 Range 27W
 Well No. #1 Lavda
 Company A. C. Swain

Sec. 4 Twp. 4 R. 27W ✓
 Well No. #1 Lavda Farm
A. C. Swain Company
Lohman & Johnson Contractor

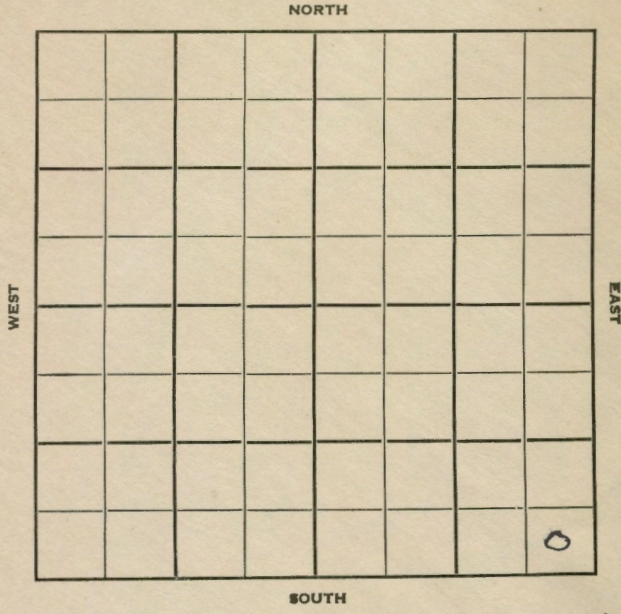

Wildcat
 _____ Ft. from N. Line
330 _____ Ft. from S. Line
330 _____ Ft. from E. Line
 _____ Ft. from W. Line

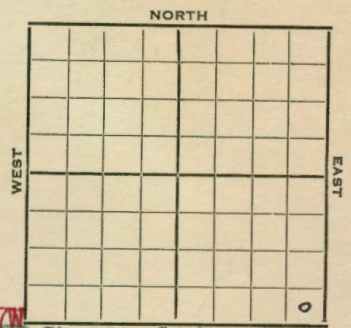

SE SE SE
 MCPC has NE/4 of 8-4-27W Skelly ⁵⁰⁰⁰ 2500

1952	Elv. 2640' DF REPORT
5/28	Spud 5-22-52 8" @ 212' Anhy 2176' Drlg. 3185'
6/4	Spud 5-22-52 D&A TD 4040 8" @ 212 Anhy 2176 Lans. 3570 DST 3578-3620 open 1 hr. Rec. 20' ocm BKC 3772 Arb. 3995-4040 TD D&A ABANDONED

16

