


KANSAS Decatur

Section 14 Township 4 Range 27-W

Well No. #1 J. Petraeck

Company H. L. Hunt
Wildcat

NORTH

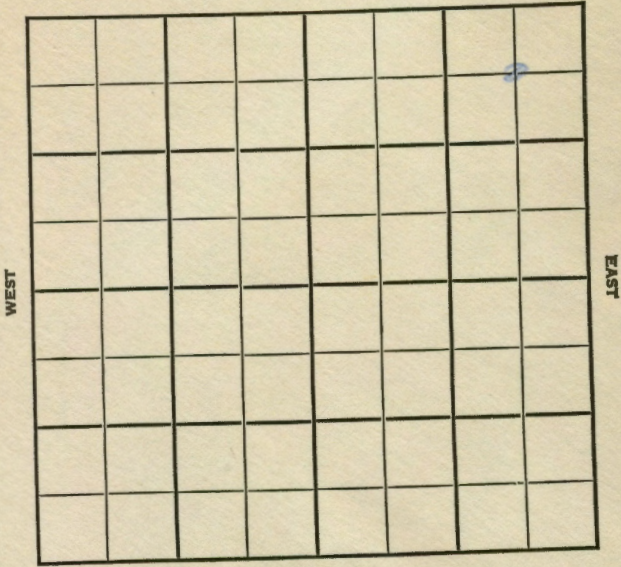

SOUTH

KANSAS

Decatur

Sec. 14 Twp. 4 R. 27W

Well No. #1 J. Petraeck Farm

H. L. Hunt Company

Wildcat

660' Ft. from N. Line


_____ Ft. from S. Line

660' Ft. from E. Line

_____ Ft. from W. Line

C NE NE

NORTH

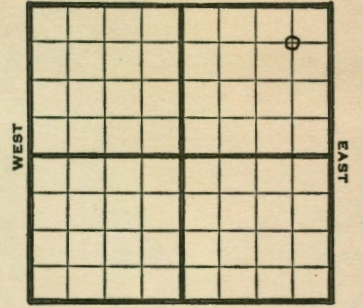

SOUTH

1948	Elev. 2594' REPORT
6/30	Anhy. 2150' Topeka 3265' Lans. 3471' Drlg. 3644'
7/8	Congl 3926' Arbuckle 3989' TD 4020'
ABANDONED	

Map No. 135 Sec. 14 Twp. 4 R. 27W

Well No. 1 J. Petraeck

H. L. Hunt Company

ABANDONED Contractor

C NE NE

SECTION PLAT

660 Ft. from N. Line

Ft. from S. Line

660 Ft. from E. Line

Ft. from W. Line

Decatur County

Location _____

Rig up _____

Drilling and Remarks:

*Comp 3926
Cut 3989*

RECORD

Cased _____ in., _____ ft.

Sand _____

Gas _____

Oil _____

Total Depth 4020

PRODUCTION

1st 24 hrs. Nat. _____

1st 24 hrs. after shot _____

Gas _____ Cu. Ft.

Dry Hole _____

Abandoned _____

Date

JUL 8 1948 19 S. J. LEWIS Scout

Sec. 14 Twp. 4 R. 27W

Well No. 1 J. Petraeck

H. L. Hunt Company

FIRST REPORT Contractor

C NE NE

SECTION PLAT

660 Ft. from N. Line

Ft. from S. Line

660 Ft. from E. Line

Ft. from W. Line

Decatur County

Location _____

Rig up _____

Drilling and Remarks:

Anhy 2150

Topeka 3265

Lans. 3471

drlg. 3644

RECORD

Cased _____ in., _____ ft.

Sand _____

Gas _____

Oil _____

Total Depth _____

PRODUCTION

1st 24 hrs. Nat. _____

1st 24 hrs. after shot _____

Gas _____ Cu. Ft.

Dry Hole _____

Abandoned _____

Date

JUN 30 1948 19 S. J. LEWIS Scout