


Section 22 Township 4 Range 27WWell No. #1 MazauekCompany H. Gore

NORTH

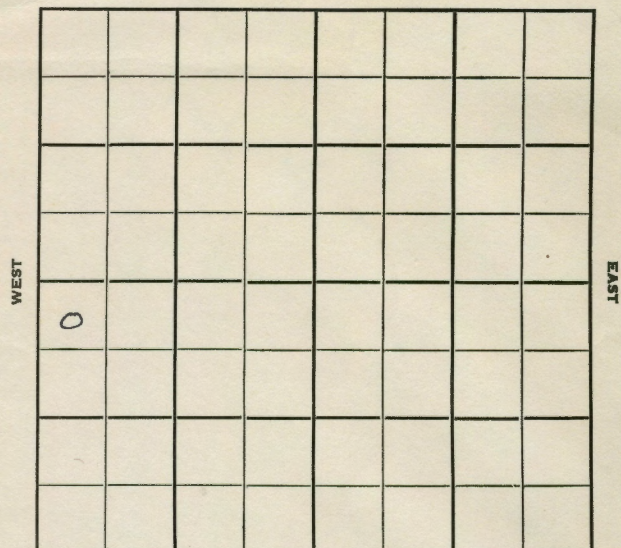

SOUTH

12

Sec. 22 Twp. 4 R. 27 WWell No. # 1 Mazauek FarmH. Gore CompanyVeeder Contr. Contractor

Wildcat


330 Ft. from N. Line

Ft. from S. Line

Ft. from E. Line

330 Ft. from W. LineNW NW SW
Champlin-Sun-Skelly DHM

NORTH

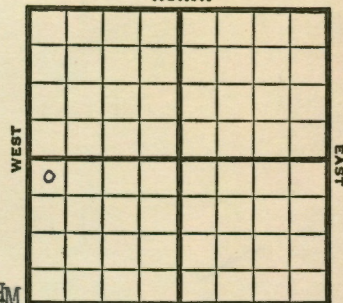

SOUTH

1951 **Elev. 2580'** REPORT10/10 Spud 10-7-51
8" @ 219'
Drlg. 800'10/31 Spud 10-7-51
D&A TD 4135'
8" @ 219'
Top. 3347' Heeb. 3538'
Br. line 3561' Lans. 3574'
DST 3621-64 open 1 hr. rec. 60'
mud B KC 3781 Cong. 3953
Arb. 4080 TD 4135'
D&A**ABANDONED**

[illegible]

J. E. TYRA

County **Decatur** State **Kansas**

Sec. **22** (Blk. **4**) (Sur. **27W**) Map No.

Operator **E. Gore**

Well No. **1** Farm **Mazanek**

Elev. Location **NW NW SW**

FIRST REPORT

330 Ft. From **N** Line **SW**

330 Ft. From **W** Line **Quarter**

Ist. Report **OCT 1 0 1951**

Completion

Remarks **Champlin-Sun-Skelly**
DHM
Veeder - Contr.

Spudding Date **10-7-51**

Drig. Data **Wildcat**

8" @ 219' Drig. 800

J. E. TYRA