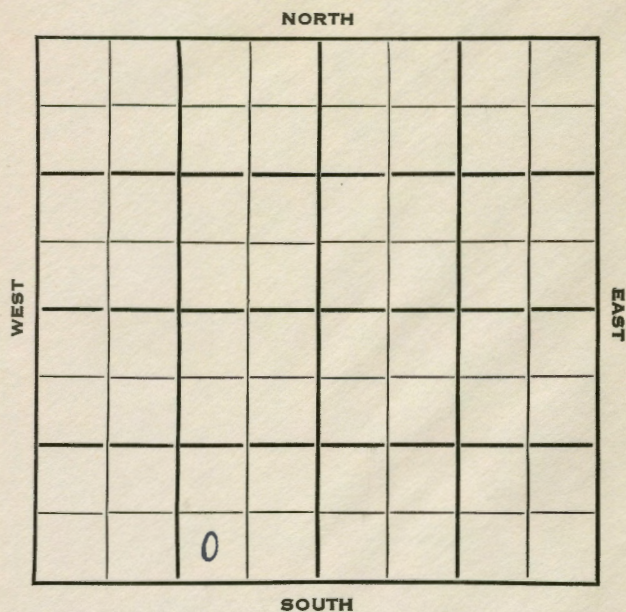


Section 25 Township 4 Range 27 WWell No. # 5 JenningsCompany Texas Company

14

WELL NO.

#5 Jennings

FARM

COMPANY

Texas Company

CONTRACTOR

Hannum Drlg.
Jennings Pool


330 Ft. from N. Line

Ft. from S. Line

990 Ft. from E. Line

Ft. from W. Line

SW SE SW

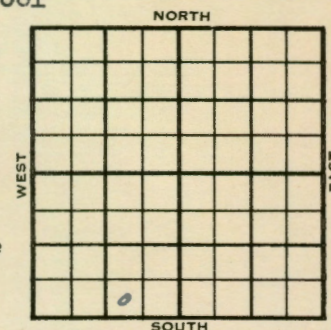

1953

ELEVATION

Elev. 2599'

REPORT

10/21

Spud 10-15-53

10" @ 710'

Drlg 2400'

10/28

Howard 3264', Top 3329', Heeb 3457'**Lans. 3498'**

Drlg. 3612'

11/4

DST 3691-97', 1 hr, 15' M 1095#

TD 3697' 7" @ 3697

11/11

CO 3697' NS DD 3699 5GOPH 5 hrs.

Sd-o-frac. S/1 BOPH 29 GO & 2½

GWPH PB 3675'

11/18

NR

11/24

Spud 10-15-53

Oil Well

TD 3699'

10" @ 710'

Howard 3264', Top 3329', Heeb 3457,**Lans 3498,**

DST 3691'-97' opn 1 hr, rec 15' Mud 1095#

TD 3697'

7" @ 3697'

CO to 3697

DD 3699 5 goph 5 hr. sd-oil-frac

S/ 1 boph 29 go 2½ gwph PB 3675

19/ 3608-14 1 qt oil ph 500 A S/ 45
bo 9 hr. Comp 146 bopd. **COMPLETED**

DX-78

J. G. McGEHEE

J. G. McGEHEE