



Section 25 Township 4 Range 27W
Well No. 2 E.B. Jennings
Company Texas Company

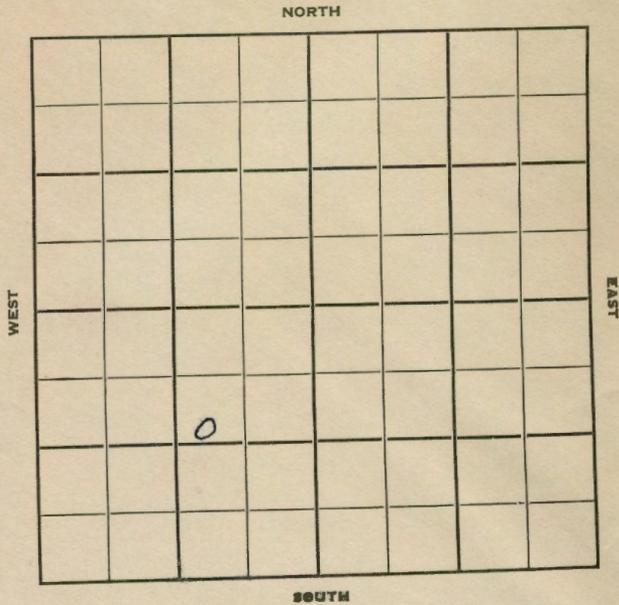

11

Sec. 25 Twp. 4 R. 27W
Well No. #2 E. B. Jennings Farm _____
Texas Company Company _____

990 Ft. from N. Line
_____ Ft. from S. Line
990 Ft. from E. Line
_____ Ft. from W. Line
SW NE SW

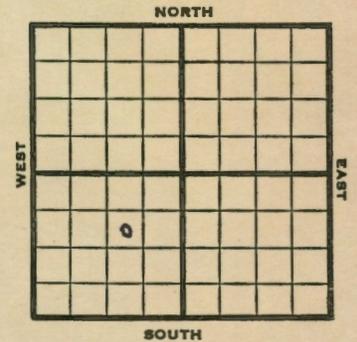

1952 **Elev. 2521'** REPORT

12/23 Spud 12-20-52
10" @ 680
WOC
1/1 Drlg. 3410
1/8 Top 3251 Heeb 3381 Lans 3423
RTD 3532 7" @ 3532 CO 3532 DD 3535
1 GOPH DD 3543
1/14 Spud 12-20-52
Oil Well
TD 3535'
10" @ 680
Top 3251, Heeb. 3381, Lans 3423
7" @ 3532
TD 3534
CO to 3534 DD 3535 1 goph
1000A 3 1/2 bo 1/2 bwph
P/50 bo 3 bw 8 hrs.
Comp. 150 bopd 9 bw

COMPLETED

County Decatur State Kansas
 Sec. 25 (Blk. 4 (Sur. 27W Map No. 4)
 Operator Texas Company
 Well No. 2 Farm E. B. Jennings
 Elev. 2521 Location SW NE SW

990 Ft. From N Line SW
 990 Ft. From E Line Quarter
 Ist. Report
 Completion JAN 14 1953
 Remarks
 Spudding Date 12-20-52

Drilg. Data Oil well TD 3535
10" @ 680 Top. 3251 Heeb. 3381
Lens. 3423 7" @ 3532 TD 3534
CO to 3534 DD 3535 1 goph 1000 A
3 1/2 bo 1/2 bwph P/ 50 bo 3 bw 8 hr.
Comp. 150 bopd 9 bw

J. G. McGEHEE

County Decatur State Kansas
 Sec. 25 (Blk. 4 (Sur. 27W Map No. 4)
 Operator Texas Company
 Well No. 2 Farm E. B. Jennings
 Elev. Location SW NE SW

990 Ft. From N Line SW
 990 Ft. From E Line Quarte
 Ist. Report DEC 23 1952
 Completion
 Remarks
 Spudding Date 12-20-52

Drilg. Data
10" @ 680 WOC

J. G. McGEHEE